TIGHT HOLE

SIDE ONE

TIGHT HOLE

STATE CORPORATION COMMISSION OF KANSAS
OIL & GAS CONSERVATION DIVISION
WELL COMPLETION OR RECOMPLETION FORM
ACO-1 WELL HISTORY
DESCRIPTION OF WELL AND LEASE

API NO. 15-109-20,470

County Logan

CN/2 SW NW Sec. 10 Twp. 11S Rge. 32 East X West

3630 Ft North from Southeast Corner of Section
4620 Ft West from Southeast Corner of Section
(Note: Locate well in section plat below)

Lease Name Nickelson "H" Well # 1

Field Name

Producing Formation N/A

Elevation: Ground 3062' KB 3067'

Operator: License # 5063
Name Energy Exploration, Inc.
Address 1002 S. Broadway
City/State/Zip Wichita, KS 67211

Purchaser N/A

Operator Contact Person Kevin Howard
Phone (316) 267-7336

Contractor: License # 5422
Name Abercrombie Drilling, Inc.

Wellsite Geologist Mark Galyon
Phone 316/262-1841

APR 13 1989
KANSAS GEOLOGICAL SURVEY
WICHITA BRANCH
RECEIVED
STATE CORPORATION COMMISSION
APR 7 1989
CONSERVATION DIVISION
Wichita, Kansas

Section Plat

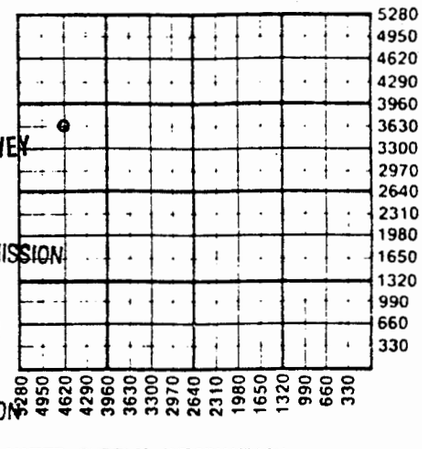

Designate Type of Completion
X New Well ___ Re-Entry ___ Workover
___ Oil ___ SWD ___ Temp Abd
___ Gas ___ Inj ___ Delayed Comp.
X Dry ___ Other (Core, Water Supply etc.)

If OWWO: old well info as follows:
Operator
Well Name
Comp. Date Old Total Depth

WELL HISTORY

Drilling Method:
X Mud Rotary ___ Air Rotary ___ Cable

2-13-89	2-22-89	2-23-89
Spud Date	Date Reached TD	Completion Date

4750'	
Total Depth	PBTD

Amount of Surface Pipe Set and Cemented at 305 feet
Multiple Stage Cementing Collar Used? ___ Yes ___ No
If yes, show depth set feet
If alternate 2 completion, cement circulated
from feet depth to w/ SX cmt
Cement Company Name
Invoice #

WATER SUPPLY INFORMATION
Disposition of Produced Water: ___ Disposal
Docket # ___ Repressuring

Questions on this portion of the ACO-1 call:
Water Resources Board (913) 296-3717
Source of Water:
Division of Water Resources Permit #

___ Groundwater Ft North from Southeast Corner
(Well) Ft West from Southeast Corner of
Sec Twp Rge ___ East ___ West

X Surface Water Ft North from Southeast Corner
(Stream, pond etc) Ft West from Southeast Corner
Sec Twp Rge ___ East ___ West

___ Other (explain)
(purchased from city, R.W.D. #)
Lanny Hockersnth, RR 1, Oakley, KS 67748

NSTRUCTIONS: This form shall be completed in triplicate and filed with the Kansas Corporation Commission, 200 Colorado Derby Building, Wichita, Kansas 67202, within 120 days of the spud date of any well. Rule 82-3-130, 82-3-107 and 82-3-106 apply.
Information on side two of this form will be held confidential for a period of 12 months if requested in writing and submitted with the form. See rule 82-3-107 for confidentiality in excess of 12 months.
One copy of all wireline logs and drillers time log shall be attached with this form. Submit CP-4 form with all plugged wells. Submit CP-111 form with all temporarily abandoned wells.

All requirements of the statutes, rules and regulations promulgated to regulate the oil and gas industry have been fully complied with and the statements herein are complete and correct to the best of my knowledge.

gnature
Joseph D. Mace, President
Title Date 4-6-89

Subscribed and sworn to before me this 6th day of April 19 89
Notary Public Cheryl L. Idleman
Date Commission Expires 2-3-93

CHERYL L. IDLEMAN
NOTARY PUBLIC
STATE OF KANSAS
My Appt. Exp. 2-3-93

K.C.C. OFFICE USE ONLY
F ✓ Letter of Confidentiality Attached
C ✓ Wireline Log Received
C ___ Drillers Timelog Received
Distribution
___ KCC ___ SWD/Rep ___ NGPA
✓ KGS ___ Plug ___ Other (Specify)

Sec. 10 Twp. 11 Rge. 32 W

Form ACO-1 (5-86)