


DX 78-1

Section 32 Township 11 Range 16W

Well No. 1 Potter

Company Jones, Shelburne & Farmer

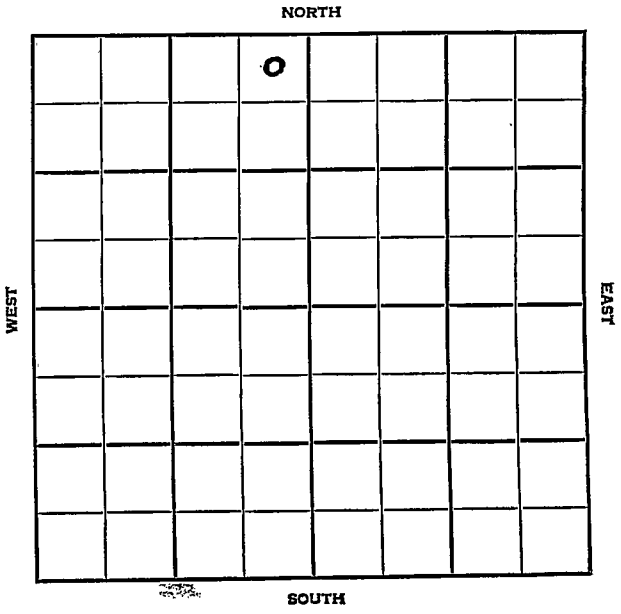

Ellis KANSAS

SEC.	TWP.	R.
32	11	16W

WELL NO.

1 Potter

COMPANY

FARM

Jones Shelburne & Farmer

CONTRACTOR


Wildcat

330 Ft. from N. Line

Ft. from S. Line

330 Ft. from E. Line

Ft. from W. Line

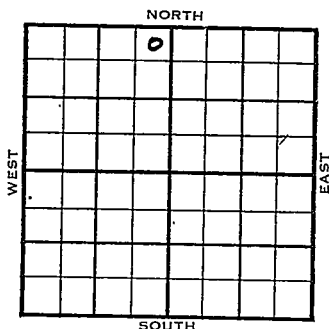

NE NE NW

	ELEVATION	REPORT
1954	1844	

8/4 Spdg 7-30-54
8" @ 196
Drlg. 2640

8-11 Spdg 7-30-54
D&A
TD 3447
8" @ 196
Heeb 3014 Lans. 3063
DST 3093-3117 open 20 min. Rec. 6'
mud 550#
Cong. 3362 Arb. 3441
TD 3447
D&A

ABANDONED

County **Ellis** State **Kansas**
 Sec. **32** (Blk.) **11** (Sur.) **16W** Map No.
 Operator **Jones, Shelburne & Farmer.**
 Well No. **1** Farm **Potter**
 Elev. Location **NE NE NW**

FIRST REPORT


330 Ft. From **N** Line **NW**
330 Ft. From **E** Line Quarter
 1st. Report **AUG 4 1954**
 Completion
 Remarks

Drilg. Date **7-30-54**
Wildcat

8" @ 196 drilg. 2640

J. G. McGEHEE

County Ellis State Kansas
 Sec. 32 (Blk.) 11 (Sur.) 16W Map No.
 Operator Jones, Shelburne & Farmer
 Well No. 1 Farm Potter
 Elev. 1844 Location NE NE NW

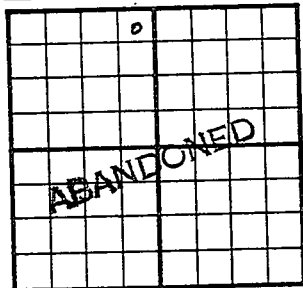

330 Ft. From N Line NW
330 Ft. From E Line Quarter
 1st. Report
 Completion AUG 11 1954
 Remarks Wildcat

Spudding Date 7-30-54

Drlg. Data D & A TD 3447
8" @ 196 Heeb. 3014 Lans. 3063
DST 3093-3117 open 20 min. Rec. 6' mud
550# Cong. 3362 Arb. 3441 TD 3447
D & A