


Russell

KANSAS

SECTION 32 TOWNSHIP 11S RANGE 15W

WELL NO. #1 Abbott

COMPANY Okmar Oil Co.

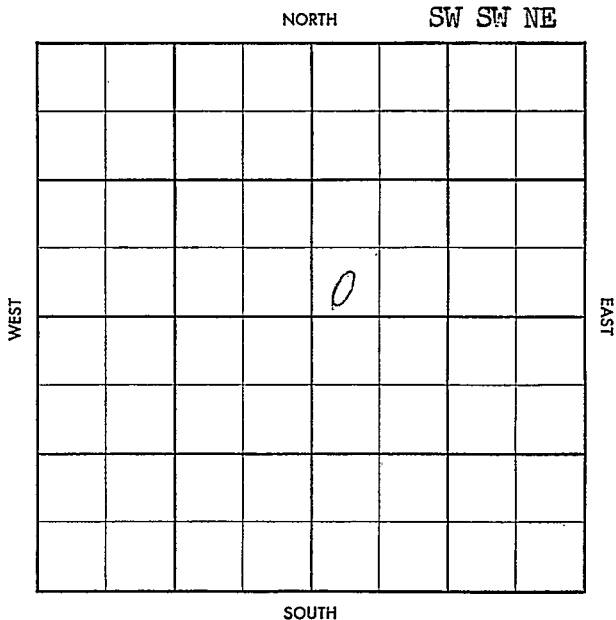

S-513-A

CO. Russell ELEV. 182278
SEC. 32 TWP. 11 RGE. 15W
COMPANY Okmar Oil Co. NO. 1

COMPLETE
FEB 12 '58

FARM Abbott
LOC. SW SW NE

A 875
TD 2626
H 2878
TR 2898
L 2929
A 3244
TD 3248

GEOL. _____
 CONTR. C-G Tools #2
 POOL Fairport
 SPUD 1/6/58
8" @ 185 w/150, WOC
JAN 15 '58 DST 2652
-71 30" 20' WCM
9PKS OIL BHP
405/20" DST
2830-60 60"
125' MCW FP 30-100 BHP
775/30" DST 2885-2915
30" 45' MLC 69C O 60'
OIL BHP 140/20" DST
2930-45 JAN 22 '58 30" 8'M
BHP 30/20 DST 2950-68
30" 225' SW BHP 370/20
DST 3150-77 30" 10'M
BHP 70/20 in log 5" 3238
WOC JAN 20 '58 FEB 5 '58 CO PD

4 1/2" 3244 CO 3248 TD
1) 2 BOPD MW 8 hrs @ 0.0
 FEB 12 '58
25 BOPD + 690 W
out

CO.
LSE.
NO.
SEC.
TWP.
RGE.