


Russell

Map No. Kansas Sec. 32 Twp. 11 R. 15^W

Well No. 2 Booth Farm

Snowden & McSweeney Company

NORTH

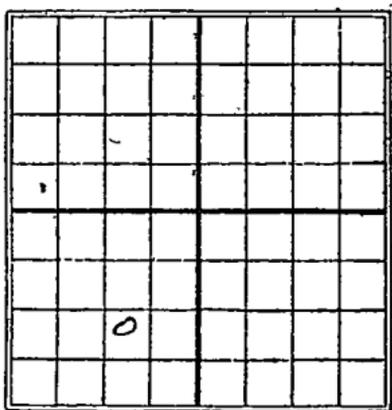

SOUTH

..... Ft. from N. Line

990 Ft. from S. Line

990 Ft. from E. Line

..... Ft. from W. Line

Date

REPORT

1925

11/11 R.O.G.

~~1926~~

3/3 Top sand 2866

F.D. 2870 250 Bbls

No Map

Map No. **KANSAS** Sec. *32* Twp. *11* R. *15W*

Well No. *2 Booth*

Snowden & McSweeney Company
Contractor

FIRST REPORTS

----- Ft. from N. Line
990 Ft. from S. Line
990 Ft. from E. Line
----- Ft. from W. Line

SECTION PLAT

	<i>0</i>		

Location -----
Rig up -----
Drilling and Remarks:

ROY

RECORD

Cased ----- in., ----- ft.
Sand -----
Gas -----
Oil -----
Total Depth -----

PRODUCTION

1st 24 hrs. Nat. -----
1st 24 hrs. after shot -----
Gas ----- Cu. Ft.
Dry Hole -----
Abandoned -----

Date

NOV 1 1 1925

S. J. LEWIS

Scout

map KANSAS

Map No. _____ Sec. *32* Twp. *11* R. *15W*

Well No. *2 Booth*

Snowden Mc Sweeney Company
Contractor

SECTION PLAT

	<i>0</i>		

_____ Ft. from N. Line

990 Ft. from S. Line

990 Ft. from E. Line

_____ Ft. from W. Line

COMPLETED

Location _____

Rig up _____

Drilling and Remarks:

MS 2866
TI 2870

250 yds.

RECORD

Cased _____ in., _____ ft.

Sand _____

Gas _____

Oil _____

Total Depth _____

PRODUCTION

1st 24 hrs. Nat. _____

1st 24 hrs. after shot _____

Gas _____ Cu. Ft.

Dry Hole _____

Abandoned _____

Date

MAR 3 1926

192

S. J. LEWIS

Scout