KANSAS


Form 51—5M—7-40—Palace

Russell

Section 32 Township 11 Range 15-W

Well No. #4 F. Booth "A"

Company Stanolind

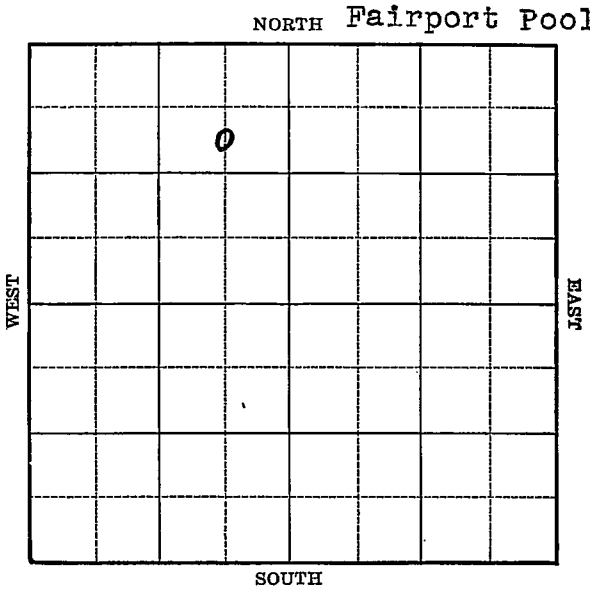

FORM 252-A 5M 1-41 PETROL KANSAS Russell

Sec. 32 Twp. 11 R. 15-W

Well No. #4 F. Booth "A" Farm

Stanolind Company


(Fairport)

990 Ft. from N. Line

Ft. from S. Line

660 Ft. from E. Line

Ft. from W. Line

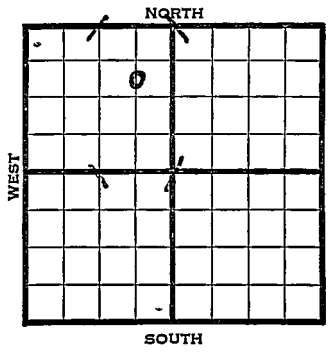

Elev. 1820

1941	REPORT
3/12	Cellar.
3/20	"
3/27	Rig.
4/2	20" - 18' 16" - 378'
	Drlg. 400'.
4/10	13" - 571' Anhy ~~875'~~ 867'
	T.D. 885' Run 10".
4/18	Anhy. 867' (Corrected)
	10" - 867' S.S/gas 1750'
	Drlg. 1940'
4/24	8" - 2388' T.D. 2440' U.R. 8".
5/1	8" - 2600' Topeka 2607-20' T.D.
	C. O.
5/8	7" - 2917' T.D. 3069'
	7" collapsed. Fishing.
5/15	" " " "
5/22	7" - 2909' Drlg. 2946'
5/28	7" - 3141' Sooy Sand 3192'
	T.D. 3200' 1600' oil 2 hours.
6/5	Basal sand 3274' H.F.W.
	Granite 3351-58' T.D.
	Shut down. OVER

1941

6/10 P.B. to 3267' 7" - 3279'
80 shots 3239-55' C.O.

6/16 1000 acid. Water.
Squeezed off perforations.

6/25 Lans. 2908'
Arb. 3239'
Granite 3351'
T.D. 3358'
P.B. to 3267'
48 shots 3197 to 3202'
3000 acid.
Potential 115 bbls., pump.
37.5 Gravity

COMPLETED

Form 26—200 Bks.—1-40—Palace Russell KANSAS

Map No. 72 Sec. 32 Twp. 11 R. 15W

Well No. 4 F. Booth "A"

Stanolind Company

FIRST REPORT Contractor

C S L NE NW

990 Ft. from N. Line


_____ Ft. from S. Line

660 Ft. from E. Line

_____ Ft. from W. Line

FAIRPORT POOL

SECTION PLAT

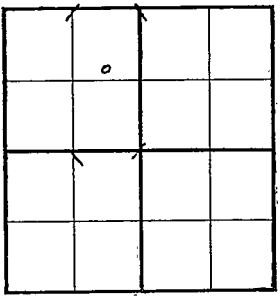

Location _____

Rig up _____

Drilling and Remarks:

Cellar

RECORD

Cased _____ in., _____ ft.

Sand _____

Gas _____

Oil _____

Total Depth _____

PRODUCTION

1st 24 hrs.-Nat. _____

1st 24 hrs. after shot _____

Gas _____ Cu. Ft.

Dry Hole _____

Abandoned _____

Date

MAR 12 1941 19____

S. J. LEWIS Scout

Form 26 200 Bks. 5-41 McW. Russell KANSAS

Map No. 72 Sec. 32 Twp. 11 R. 15W

Well No. 4 F. Booth "A"

Stanolind Company

Contractor

COMPLETED

C S L NE NW

990 Ft. from N. Line


Ft. from S. Line

660 Ft. from E. Line

Ft. from W. Line

FAIR PORT POOL

SECTION PLAT

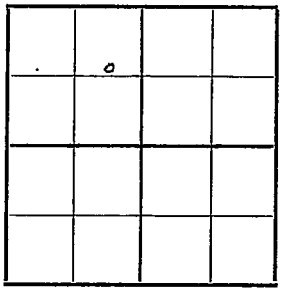

Location

Rig up

Drilling and Remarks:

Lime 2908'
Gr Y 3239
Granite 3351
P.B. 3267.
48 Shots 3187-3202
8000 Acid
Pump. 115 B.J.
375 Gr

RECORD

Cased in., ft.

Sand

Gas

Oil

Total Depth 3358

PRODUCTION

1st 24 hrs. Nat.

1st 24 hrs. after shot

Gas Cu. Ft.

Dry Hole

Abandoned

Date

JUN 25 1941 19

S. J. LEWIS Scout