


Russell

Map No. Kansas Sec. 32 Twp. 11 R. 15<sup>w</sup>

Well No. 3 Dodge Farm  
Serby Street & Stearns Company

NORTH

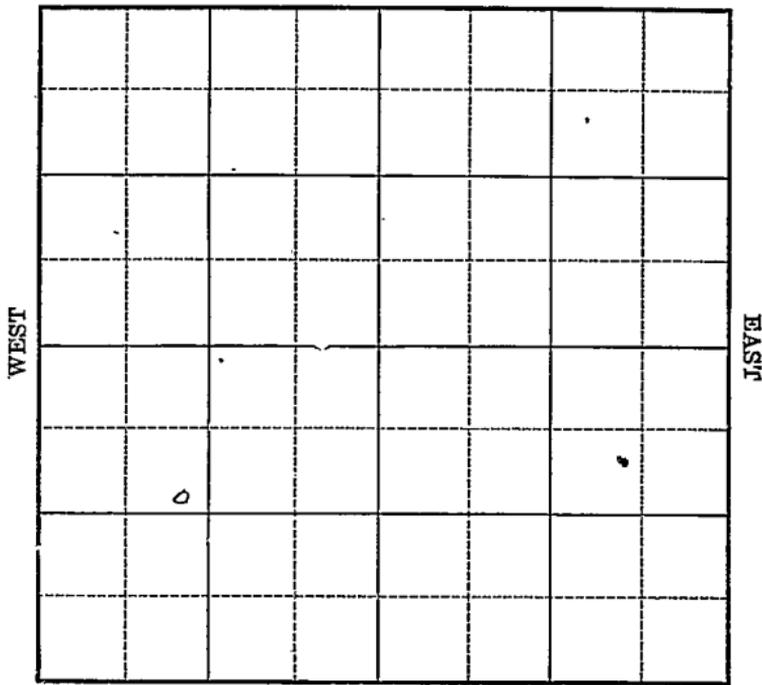

SOUTH

Location \_\_\_\_\_

Rig Up \_\_\_\_\_

Drilling Remarks \_\_\_\_\_  
\_\_\_\_\_  
\_\_\_\_\_  
Drilling Remarks \_\_\_\_\_  
\_\_\_\_\_  
\_\_\_\_\_  
**RECORD**

Cased \_\_\_\_\_ in. \_\_\_\_\_ ft.  
Sand \_\_\_\_\_  
Gas \_\_\_\_\_  
Oil \_\_\_\_\_  
Total Depth \_\_\_\_\_

**PRODUCTION**

1st 24 hrs. Nat. \_\_\_\_\_  
1st 24 hrs. after shot \_\_\_\_\_  
Gas \_\_\_\_\_ cu. ft.  
Dry Hole \_\_\_\_\_  
Abandoned \_\_\_\_\_



Map No. **KANSAS** Sec. *32* Twp. *11* R. *15-18*

Well No. *3 Dodge*

*Derby Steeple & Sons* Company  
Contractor

SECTION PLAT

*990* Ft. from N. Line

\_\_\_\_\_ Ft. from S. Line

\_\_\_\_\_ Ft. from E. Line

*990* Ft. from W. Line


FIRST REPORTS

Location \_\_\_\_\_

Rig up \_\_\_\_\_

Drilling and Remarks:

*Location*

RECORD

Cased \_\_\_\_\_ in., \_\_\_\_\_ ft.

Sand \_\_\_\_\_

Gas \_\_\_\_\_

Oil \_\_\_\_\_

Total Depth \_\_\_\_\_

PRODUCTION

1st 24 hrs. Nat. \_\_\_\_\_

1st 24 hrs. after shot \_\_\_\_\_

Gas \_\_\_\_\_ Cu. Ft.

Dry Hole \_\_\_\_\_

Abandoned \_\_\_\_\_

Date

*FB* 24 192692

S. J. LEWIS

Scout

Map No. KANSAS Sec. 32 Twp. 11 R. 15W

Well No. 3 Dodge

Dodge-Steeter & Stone Company

Contractor

SECTION PLAT


990 Ft. from N. Line

----- Ft. from S. Line

----- Ft. from E. Line

990 Ft. from W. Line

**COMPLETED**

Location -----

Rig up -----

Drilling and Remarks:

Sand 2837 to 2848.

130886

Na 2.

RECORD

Cased ----- in., ----- ft.

Sand -----

Gas -----

Oil -----

Total Depth -----

PRODUCTION

1st 24 hrs. Nat. -----

1st 24 hrs. after shot -----

Gas ----- Cu. Ft.

Dry Hole -----

Abandoned -----

Date

MAY 26 1926

192

S. J. LEWIS

Scout