KANSAS


FORM 51 IOM 12-46 PETROL

Russell

Section 32 Township 11 Range 15W

Well No. 1 Kollman

Company B. & R. Drilling et al

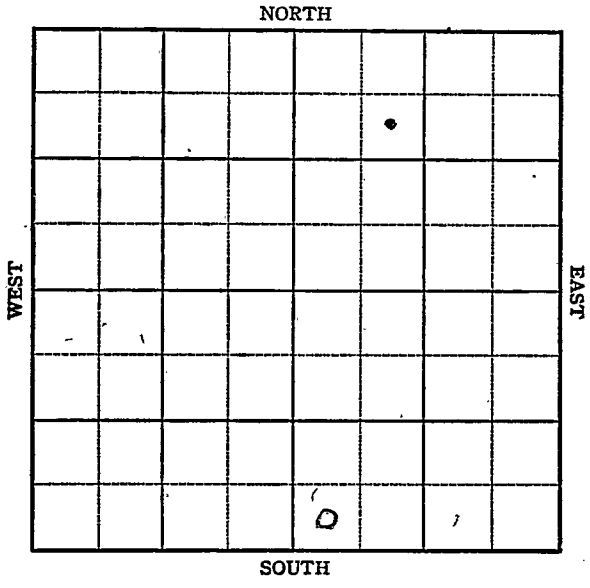

FORM 252-A
5M 12-46 PETROL

KANSAS


Russell

Sec. 32 Twp. 11 R. 15W

Well No. #1 Kollman Farm

B & R Drlg et al Company

Fairport Pool

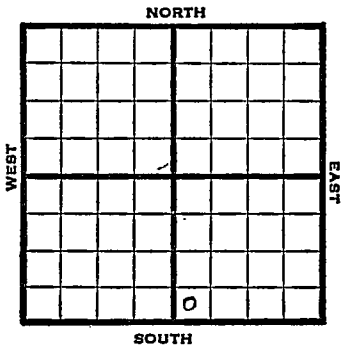

Ft. from N. Line

330 Ft. from S. Line

Ft. from E. Line

330 Ft. from W. Line

SW SE

REPORT

1947 Elev. 1722'

5/21 Location

5/27 8" @ 550'
WOC

6/3 Lansing 2826
Drlg 2910

6/10 Gorham 3148-59
5" @ 3147
Rust

6/17 TD 3167 water
PB 2950'

6/25 TD 3167'
5" @ 3147
Gorham 3148'
Abandoned

ABANDONED

Form 26 200 Bks. 10-46 Petrol

Kansas KANSAS

Fairport Pool

Map No. 72 Sec. 32 Twp. 11 R. 15W


Well No. 1 Kollman

B & R Drlg. etal. Company

FIRST REPORT Contractor

SW SE

SECTION PLAT

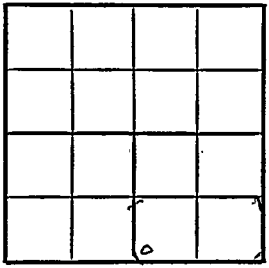

____ Ft. from N. Line

330 Ft. from S. Line

____ Ft. from E. Line

330 Ft. from W. Line

Russell County

Location X

Rig up

Drilling and Remarks:

RECORD

Cased ____ in., ____ ft.

Sand

Gas

Oil

Total Depth

PRODUCTION

1st 24 hrs. Nat.

1st 24 hrs. after shot

Gas ____ Cu. Ft.

Dry Hole

Abandoned

Date

MAY 2 1 1947 19

S. J. LEWIS Scout

Form 26 200 Bks. 10-46 Petrol

Kansas

Fairport Pool

Map No. 72 Sec. 32 Twp. 11 R. 15W

Well No. 1 Kollman


B & R Drlg. etal. Company

ABANDONED Contractor

SW SE

E 1/1722

SECTION PLAT

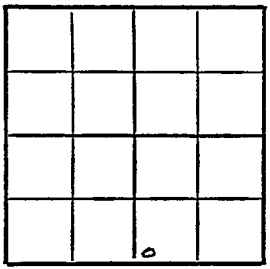

____ Ft. from N. Line

330 Ft. from S. Line

____ Ft. from E. Line

330 Ft. from W. Line

Russell County

Location

Rig up

Drilling and Remarks:

Gorham 3148.

5" @ 3147

RECORD

Cased ____ in., ____ ft.

Sand

Gas

Oil

Total Depth 3167

PRODUCTION

1st 24 hrs. Nat.

1st 24 hrs. after shot

Gas ____ Cu. Ft.

Dry Hole

Abandoned

Date

JUN 25 1947 19

S. J. LEWIS Scout