

KANSAS

Ellis

FORM 51 5M PETROL

32

Section ~~29~~ ~~33~~ Township 11 Range 18W

Well No. 1 Johnson "D"

Company Champlin Ref.

NORTH

				0			

SOUTH

2

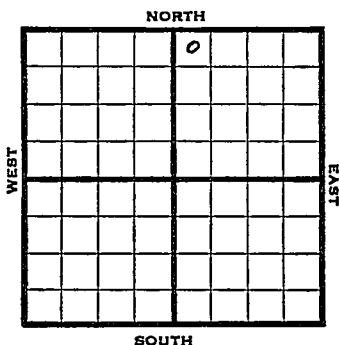
WEST

EAST

Sec. 32 ~~22~~ ³³ Twp. 11 R. 18 ~~W~~Well No. #1 Johnson "D" FarmChamplin Ref. Company330 Ft. from N. Line

Ft. from S. Line

Ft. from E. Line

330 Ft. from W. Line

NW NE

1945		Elev. 1989					REPORT				
10/24	Location										
10/31	Dr 18" @ 1700'										
11/7	Dr 18" @ 3142' per hr.										
11/14	8" @ 1200'										
	Topeka 3005										
	Lans 3353										
	Arb. 3521										
	TD 3526										
	5" @ 3521 RUST										
11/21	Swab 26 oil per hr. 6 hrs.										
11/28	" " " " "										
12/5	" " " " "										
12/12	" " " " "										
12/20	" " " " "										
12/29	" " " " "										
1946											
1/9	Arb. 3521										
	5" @ 3521										
	TD 3526'										
	Pump 172 Pot.										
	Grav. 34.6										

COMPLETED

KANSAS

Kansas

Pool Name BemisMap No. 71 Sec. 29 Twp. 11 R. 18WWell No. 1 Johnson "D"

Champlin Ref.

Company

FIRST REPORT

Contractor

NW NE

SECTION PLAT

330 Ft. from N. Line Ft. from S. Line Ft. from E. Line330 Ft. from W. Line

		0	

Ellis CountyLocation XRig up

Drilling and Remarks:

RECORD

Cased in., ft.Sand Gas Oil Total Depth

PRODUCTION

1st 24 hrs. Nat. 1st 24 hrs. after shot Gas Cu. Ft.Dry Hole Abandoned

Date

OCT 24 1945 19S. J. LEWIS

Scout

KANSASKansas Pool Name BemisMap No. 71 Sec. 33 Twp. 11 R. 18WWell No. 1 Johnson "D"

Champlin Ref. _____ Company _____

CORRECTION

Contractor _____

NW NE

SECTION PLAT330 Ft. from N. Line

_____ Ft. from S. Line

_____ Ft. from E. Line

330 Ft. from W. Line

		0	

Ellis County

Location _____

Rig up _____

Drilling and Remarks:
reported
29-11-18W**RECORD**

Cased _____ in., _____ ft.

Sand _____

Gas _____

Oil _____

Total Depth _____

PRODUCTION

1st 24 hrs. Nat. _____

1st 24 hrs. after shot _____

Gas _____ Cu. Ft.

Dry Hole _____

Abandoned _____

Date

OCT 31 1945 19S. J. LEWIS Scout

KANSAS

Kansas

Pool Name BemisMap No. 71 Sec. 32 Twp. 11 R. 18WWell No. 1 Johnson "D"

Champlin Ref.

Company

CORRECTION

Contractor

NW NE

SECTION PLAT330 Ft. from N. Line Ft. from S. Line Ft. from E. Line330 Ft. from W. Line

		0	

Ellis County

Location

Rig up

Drilling and Remarks:

reported

33-11-18W

RECORDCased in., ft.

Sand

Gas

Oil

Total Depth

PRODUCTION

1st 24 hrs. Nat.

1st 24 hrs. after shot

Gas Cu. Ft.

Dry Hole

Abandoned

Date

NOV 7 1945

19

S. J. LEWIS

Scout

KANSAS ~~Kansas~~ Pool Name BemisMap No. 71 Sec. 32 Twp. 11 R. 18WWell No. 1 Johnson "D"

Champlin Ref. _____ Company

COMPLETED

Contractor

NW NE

E 1, 1988
SECTION PLAT

		0	

330 Ft. from N. Line

_____ Ft. from S. Line

_____ Ft. from E. Line

330 Ft. from W. Line

Ellis County

Location _____

Rig up _____

Drilling and Remarks:

As 35215' 03521Pump 172 Prod.34 1/2

RECORD

Cased _____ in. _____ ft.

Sand _____

Gas _____

Oil _____

Total Depth 3526

PRODUCTION

1st 24 hrs. Nat. _____

1st 24 hrs. after shot _____

Gas _____ Cu. Ft.

Dry Hole _____

Abandoned _____

Date

JAN 9 1946 19 S. J. LEWIS Scout