

KANSAS

FORM 51 IOM 12-46 PETROL

Ellis County


Section 32 Township 11 Range 17-W

Well No. 1 Hadley

Company York State

Bemis Pool

NORTH

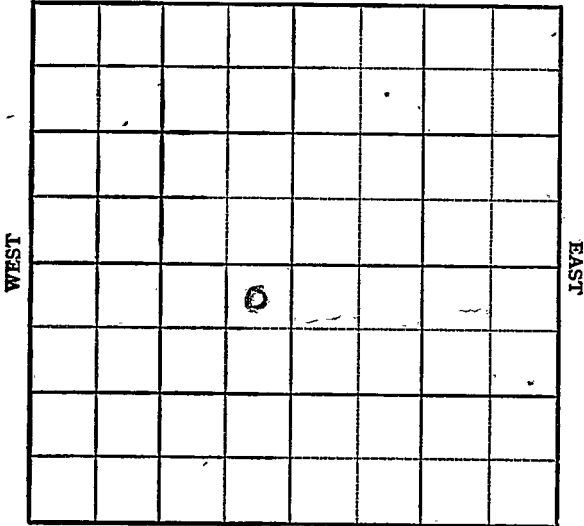

SOUTH

KANSAS

Ellis



Sec. 32 Twp. 11 R. 17-W

Well No. #1 Hadley Farm \_\_\_\_\_

York State Company \_\_\_\_\_

Bemis Pool


330 Ft. from N. Line

\_\_\_\_\_ Ft. from S. Line

330 Ft. from E. Line

\_\_\_\_\_ Ft. from W. Line

NE SW

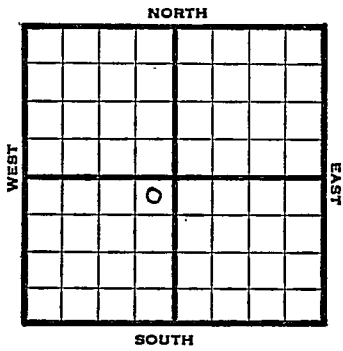

1947

Elev 2109' REPORT

- 7/2 Drlg 850'
- 7/8 8" @ 1334  
Anhydrite 1334  
Drlg 2600'
- 7-16 Arbuckle 3612  
18 TD  
5" @ 3613  
RUST
- 7/22 TD 3623'  
1500 Acid  
2030' Oil in 20 hrs.
- 7/29 " "
- 8/6 " "
- 8/13 " "
- 8/20 Arb 3612'  
5% @ 3613'  
Acid 1500  
Pump 97 oil / 27 W Pot.  
Gr. 36  
T.D. 3623'  
Complete

**COMPLETED**

Map No. \_\_\_\_\_ Sec. 32 Twp. 11 R. 17W

Well No. 1 Hadley

York State \_\_\_\_\_ Company

FIRST REPORT \_\_\_\_\_ Contractor

NE SW

SECTION PLAT

330 Ft. from N. Line

\_\_\_\_\_ Ft. from S. Line

330 Ft. from E. Line

\_\_\_\_\_ Ft. from W. Line

		o	

Ellis County

RECORD

Location \_\_\_\_\_

Cased \_\_\_\_\_ in., \_\_\_\_\_ ft.

Rig up \_\_\_\_\_

Sand \_\_\_\_\_

Drilling and Remarks:

Gas \_\_\_\_\_

Oil \_\_\_\_\_

drlg. 850

Total Depth \_\_\_\_\_

PRODUCTION

1st 24 hrs. Nat. \_\_\_\_\_

1st 24 hrs. after shot \_\_\_\_\_

Gas \_\_\_\_\_ Cu. Ft.

Dry Hole \_\_\_\_\_

Abandoned \_\_\_\_\_

Date

JUL 2 1947 19

S. J. LEWIS Scout

Kansas

Map No. 71 Sec. 32 Twp. 11 R. 17W

Well No. 1 Hadley

York State Company

COMPLETE

Contractor

NE SW

*E. 2108*

SECTION PLAT

330 Ft. from N. Line

         Ft. from S. Line

330 Ft. from E. Line

         Ft. from W. Line

	6		

Ellis County

Location                                 

Rig up                                 

Drilling and Remarks:

*Cor 8612*  
*5" @ 8613*  
*1500 @ 8614*  
*Run 970 oil + 27W*  

RECORD

Cased          in.,          ft.

Sand                                 

Gas                                 

Oil                                 

Total Depth 8623

PRODUCTION

1st 24 hrs. Nat.                         

1st 24 hrs. after shot                         

Gas                                  Cu. Ft.

Dry Hole                                 

Abandoned                                 

Date

AUG 20 1947 19

S. J. LEWIS Scout