

Sec. 32 Twp. 11 R. 17W

Well No. #1 Hadley Farm

Great Lakes Carbon Company


Burnett Pool

330' Ft. from N. Line

_____ Ft. from S. Line

990' Ft. from E. Line

_____ Ft. from W. Line

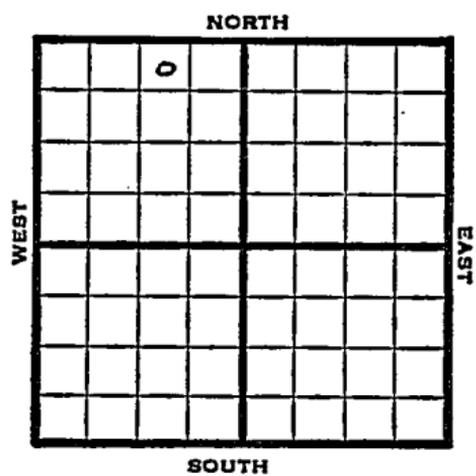

NW NE NW

1949

Elev 2023' REPORT

- 6/15 RUR
- 6/21 8" @ 921'
Drlg 1773'
- 6/28 Lansing 3258'
Drlg 3460'
- 7/6 Arbuckle 3531'
TD 3534'
- 7/12 5" @ 3531'
TD 3551'
5 gals oil PH
- 7/20 "
- 7/27 "
- 8/3 2000 acid
3 gals oil PH
- 8/10 "
- 8/17 "
- 8/24 TD 3560'
35' of 4" liner @ 3556
- 8/31 "
- 9/7 "
- 9/14 "
- 9/21 "
- 9/28 "
- 10/5 "
- 10/12 "
- 10/19 TD 3560'
Arb. 3531'
aband.

ABANDONED

Ellis County Kansas State

Map No. _____ Sec. 32 Twp. 11 R. 17W

Well No. 1 Hadley

Great Lakes Carbon Company

Contractor _____

NW NE NW

FIRST REPORT
SECTION PLAT

330 Ft. from N. Line

_____ Ft. from S. Line

990 Ft. from E. Line

_____ Ft. from W. Line

Burnett Pool

Remarks:

R U R



Date JUN 15 1949

Scout S. J. LEWIS

Kansas

Map No. _____ Sec. 32 Twp. 11 R. 17W

Well No. 1 Hadley

Great Lakes Carbon Company

ABANDONED

Contractor

NW NE NW

E/2023
SECTION PLAT

330 Ft. from N. Line

_____ Ft. from S. Line

990 Ft. from E. Line

_____ Ft. from W. Line

	0		

Ellis County

RECORD

Location _____

Cased _____ in., _____ ft.

Rig up _____

Sand _____

Drilling and Remarks:

Gas _____

Cur & 353!

Oil _____

Total Depth 32560

PRODUCTION

1st 24 hrs. Nat. _____

1st 24 hrs. after shot _____

Gas _____ Cu. Ft.

Dry Hole _____

Abandoned _____

Date

OCT 19 1949

S. J. LEWIS Scout