

KANSAS

FORM 51 5M 4-41 PETROL


Ellis

Section 32 Township 11 Range 17-W

Well No. 1 Hadley "A"

Company Amerada

NORTH Bemis Pool

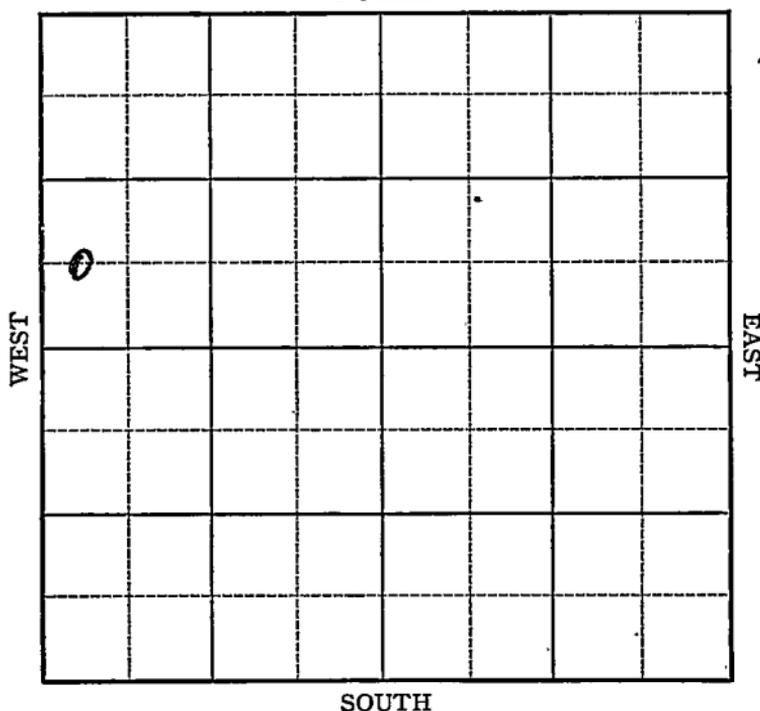

Sec. 32 Twp. 11 R. 17-W

Well No. #1 Hadley "A" Farm

Amerada

Company

(Benis)


_____ Ft. from N. Line

660 Ft. from S. Line

_____ Ft. from E. Line

330 Ft. from W. Line

Elev. 2094

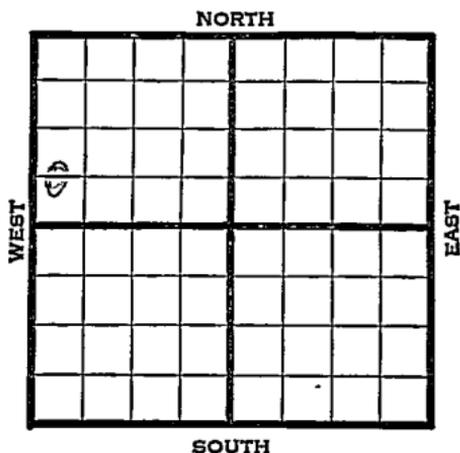

1941	REPORT
5/21	Rot ary .
5/28	8" - 1080' Drlg. 1658'
6/5	Dr lg. 3050'
6/12	Lans. 3344' Arb. 3588-3603' TD. Run 5".
6/16	5" - 3590' T.D. 3615' 1000 acid.
6/26	Swab 121 oil in 7 hours, 1/2 bailer water. P.B. to 3618'
7/3	" " " "
7/10	" " " "
7/17	" " " "
7/24	" " " "
7/30	Arb 3588' TD 3631' 5" @ 3590' 1000 acid Pump 234 Potential 31.6 Gravity

Map No. 71 Sec. 32 Twp. 11 R. 17WWell No. 1 Hadley "A"Amerada CompanyFIRST REPORT Contractor**SECTION PLAT**

C W L SW NW

 Ft. from N. Line660 Ft. from S. Line Ft. from E. Line330 Ft. from W. Line

BEMIS POOLLocation Rig up

Drilling and Remarks:

Rotary**RECORD**Cased in., ft.Sand Gas Oil Total Depth **PRODUCTION**1st 24 hrs. Nat. 1st 24 hrs. after shot Gas Cu. Ft.Dry Hole Abandoned

Date

MAY 21 1941 19S. J. LEWIS Scout

Map No. 71 Sec. 32 Twp. 11 R. 17W

Well No. 1 Hadley "A"

Amerada Petroleum Corp. Company

COMPLETED Contractor

C W L SW NW

SECTION PLAT

_____ Ft. from N. Line

660 Ft. from S. Line

_____ Ft. from E. Line

330 Ft. from W. Line

0			

BEMIS POOL

Location _____

Rig up _____

Drilling and Remarks:

Cr 7 8588
5" @ 3590
1000 acid
Pump 234 Pk.
31 6 Me

RECORD

Cased _____ in., _____ ft.

Sand _____

Gas _____

Oil _____

Total Depth 9631

PRODUCTION

1st 24 hrs. Nat. _____

1st 24 hrs. after shot _____

Gas _____ Cu. Ft.

Dry Hole _____

Abandoned _____

Date

JUL 30 1941 19

S. J. LEWIS Scout