


Map No. ELLIS KANSAS Sec. 32 Twp. 11 R. 17W

Well No. 15 Kessler Farm
Phillips Pelt Company

NORTH

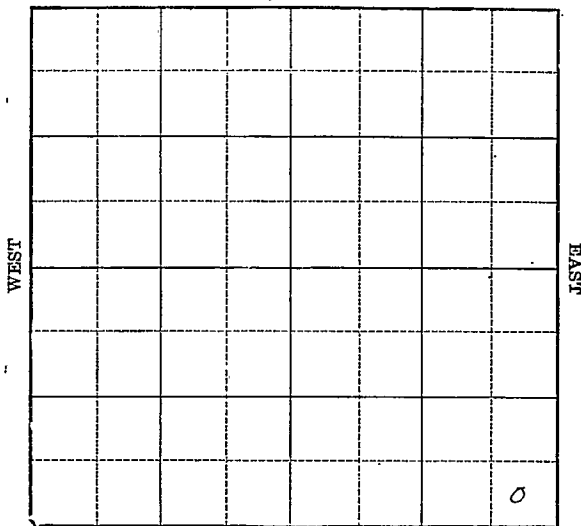

SOUTH

Location _____

Drilling Remarks _____

Rig Up _____

Drilling Remarks _____

RECORD

Cased _____ in. _____ ft.

Sand _____

Gas _____

Oil _____

Total Depth _____

PRODUCTION

1st 24 hrs. Nat. _____

1st 24 hrs. after shot _____

Gas _____ cu. ft.

Dry Hole _____

Abandoned _____

Map No. KANSAS Sec. 32 Twp. 11 R. 17^W

Well No. 1- Kessler Farm

Phillips Pet Company

NORTH

Ft. from N. Line

440 Ft. from S. Line

440 Ft. from E. Line

Ft. from W. Line

1930

WEST

EAST

SOUTH

Date

REPORT

7/9

Loc

7/16

7/23

Roll

7/30

Bldg. rig

8/6

Run pipe

8/13

Wdlg. 675'

8/20

" 1120'

8/27

Fsq. 1725'

9/3

Wdlg. 2200'

9/10

U/R 10"-2877'

9/17

Wdlg 3200'

9/24

U/R 8"-3239

10/1

Wdlg. 3298'

10/18

sank 3248-58

TD 3280
Pump 25 gal
Comp.

1932

ONDD

11/23

Old TD 3280

Cased 8"-3250

Wdlg 3289

(over)

11/30. Deepened to
TD 3305'
swab 160 bbl oil &
4 bbl water 22 hr

12/7 —

12/14- SD 3305' TD

12/21 —

12/28- TD 3305' Rng tubing

1933

1/74 —

1/11- TD 3305'

pumping 10 bbls day
No test

1/18- Cased 8"-3250

Sand 3248-3305'

TD 3305'

pump 98 bbl oil and
28 bbl water
Comp.

Ettes
 Map No. **KANSAS** Sec. *32* Twp. *11* R. *17W*
 Well No. *1 Kessler*

Phillips Pet. Company
 Contractor

SECTION PLAT

..... Ft. from N. Line
440 Ft. from S. Line
440 Ft. from E. Line
 Ft. from W. Line

FIRST REPORTS

Location *✓*
 Rig up
 Drilling and Remarks:

RECORD

Cased in., ft.
 Sand
 Gas
 Oil
 Total Depth

PRODUCTION

1st 24 hrs. Nat.
 1st 24 hrs. after shot
 Gas Cu. Ft.
 Dry Hole
 Abandoned

Date

JUL 9 1930

S. J. LEWIS Scout

Small road

Returned	
Cards	✓
Tracing	✓
France Map	✓
Scarborough Map	✓
Moody Map	✓
Scarborough Plat Book	✓
Moody Plat Book	

Map No. KANSAS Sec. 32 Twp. 11 R. 17WWell No. 1 HesslerPhillips P & S. Company

Contractor

SECTION PLAT

Ft. from N. Line

440 Ft. from S. Line440 Ft. from E. Line

Ft. from W. Line

COMPLETED

			0

Location

Rig up

Drilling and Remarks:

Sample 2588h

RECORD

Cased _____ in., _____ ft.

Sand 3248-58

Gas _____

Oil _____

Total Depth 3280

PRODUCTION

1st 24 hrs. Nat. _____

1st 24 hrs. after shot _____

Gas _____ Cu. Ft.

Dry Hole _____

Abandoned _____

Date

OCT 8 1930S. J. LEWIS Scout

*no more
papers*

Returned	
Cards	<i>CP</i>
Tracing	<i>CPK</i>
France Map	<i>+</i>
Scarborough Map	<i>+</i>
Moody Map	<i>+</i>
Scarborough Flat Book	<i>+</i>
Moody Flat Book	<i>+</i>

71 KANSAS

Map No. _____ Sec. 32 Twp. 11 R. 17

Well No. 1 Kessler

Phillips Pet Co. Company

Contractor

FIRST REPORTS


_____ Ft. from N. Line

440 Ft. from S. Line

440 Ft. from E. Line

_____ Ft. from W. Line

SECTION PLAT

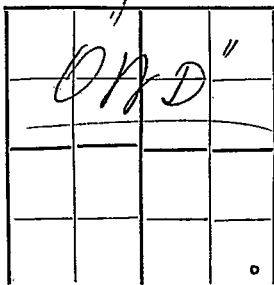

Location _____

Rig up _____

Drilling and Remarks: 200

By 3289

RECORD

Cased 8 in., 3250 ft.

Sand _____

Gas _____

Oil _____

Total Depth 3280

PRODUCTION

1st 24 hrs. Nat. _____

1st 24 hrs. after shot _____

Gas _____ Cu. Ft.

Dry Hole _____

Abandoned _____

Date

NOV 23 1932

CHAS. L. SHERWOOD

192

Scout

no wall must

Returned	<i>[Signature]</i>
Cards	<i>[Signature]</i>
Trac no	<i>[Signature]</i>
France M	<i>[Signature]</i>
Scarboro	<i>[Signature]</i>
Moody Map	<i>[Signature]</i>
Scarboro	<i>[Signature]</i>
Moody P	<i>[Signature]</i>

Ellis

71 KANSAS Sec. 32 Twp. 11 R. 17 W

Well No. 1 Kessler

Phillips Petroleum Co. Company

Contractor

COMPLETED**SECTION PLAT**

			0

Ft. from N. Line

440 Ft. from S. Line

440 Ft. from E. Line

Ft. from W. Line

Location

Rig up

Drilling and Remarks:

Pump 98 lbs Oil
28 lbs Water

RECORD

Cased 8 in., 3250 ft.

Sand 3248-3305

Gas

Oil

Total Depth 3305

PRODUCTION

1st 24 hrs. Nat.

1st 24 hrs. after shot

Gas Cu. Ft.

Dry Hole

Abandoned

Date

JAN 1 8 1933

192 CHAS. L. SHERWOOD

Scout

no war
service

Returned	<i>[Signature]</i>
Cards	<i>[Signature]</i>
Tracing	<i>[Signature]</i>
France Map	<i>X</i>
Scarborough Map	<i>X</i>
Moody Map	<i>X</i>
Scarborough Flat Book	
Moody Flat Book	