

Ellis


O. W. P. B.  
KANSAS

Section 32 Township 11 Range 17-W

Well No. #1 Schutts

Company Harbar Drilling

NORTH Bemis Pool

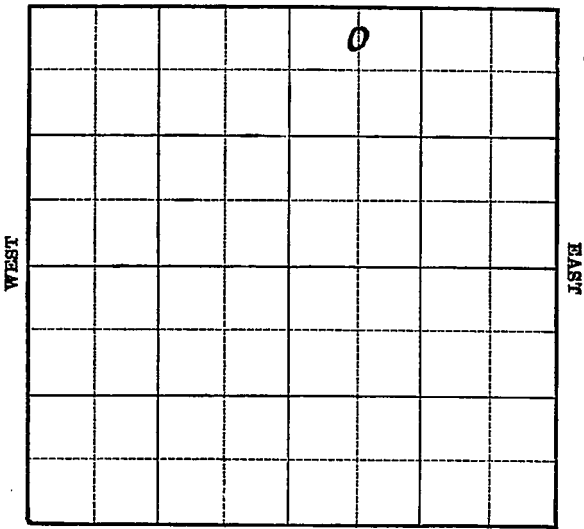

SOUTH

Sec. 32 Twp. 11 R. 17-W

Well No. #1 Schutts Farm

Harbar Drilling Company

(Bemis)


330 Ft. from N. Line

Ft. from S. Line

Ft. from E. Line

660 Ft. from W. Line

Elev. 2097

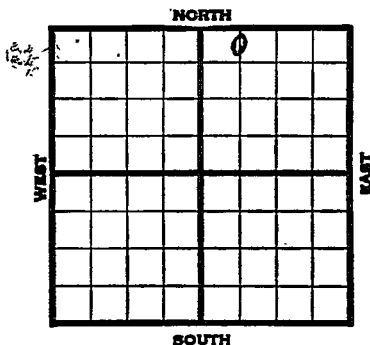

1940		REPORT
2/21	Location	
2/29	Anhy 1320'	Drlg. 1330'
3/8	10" - 1208'	Drlg. 2380'
3/14	Lans. 3325'	Drlg. 3379'
3/21	Arb. <del>3597</del> <sup>3597</sup>	T.D. 3605'
	Run pipe.	
3/28	5 1/2" - <del>3600</del> <sup>3597</sup>	RUST.
4/4	Arb. 3597'	(Corrected)
	5" - 3597'	T.D. 3631'
	P.B. 3628'	1250 <del>XXXXX</del> acid.
	Shut down.	
4/10	Arb. 3597'	
	<del>BY</del> T.D. 3631'	
	P.B. to 3628'	
	500 acid.	
	750 acid.	
	Potential 69 bbls.	
		COMPLETED
		OVER

1952

O. W. P. B.

3/5 Topeka 3070 Lans. 3325 Simp 3595  
Arb. 3597 OTD 3631 was arb. prod.  
PB 3439 12/3418-22 NS PB 3403  
12/ 3397-3401 500 A  $\frac{1}{2}$  BO plug 3  
BWPH for 9 hrs. PB 3388 23/ 3377-84  
500 A  $\frac{1}{2}$  BO plus 4 BWPH D&A

**FIRST REPORT**

**ABANDONED**

Map No. 71 Sec. 32 Twp. 11 R. 17WWell No. 1 SchuttsHarbar Drilling Company

Contractor

## FIRST REPORT

C  $N\frac{1}{2}$  NW NE330 Ft. from N. Line

\_\_\_\_\_ Ft. from S. Line

\_\_\_\_\_ Ft. from E. Line

660 Ft. from W. Line

## SECTION PLAT

		o	

## BEMIS POOL

Location X

Rig up \_\_\_\_\_

Drilling and Remarks:

## RECORD

Cased \_\_\_\_\_ in., \_\_\_\_\_ ft.

Sand \_\_\_\_\_

Gas \_\_\_\_\_

Oil \_\_\_\_\_

Total Depth \_\_\_\_\_

## PRODUCTION

1st 24 hrs. Nat. \_\_\_\_\_

1st 24 hrs. after shot \_\_\_\_\_

Gas \_\_\_\_\_ Cu. Ft.

Dry Hole \_\_\_\_\_

Abandoned \_\_\_\_\_

Date

FEB 21 1940 19S. J. LEWIS Scout

Misc. Small Maps  
Cards  
Tracing  
France Map  
Scarborough Map  
Moody Map  
Geological Dept.  
Moody & Bock

Map No. 71 Sec. 32 Twp. 11 R. 17W

Well No. 1 Schutts

Harbar Drilling Company

Contractor

**COMPLETED**

**SECTION PLAT**

C  $N\frac{1}{2}$  NW NE

330 Ft. from N. Line

\_\_\_\_\_ Ft. from S. Line

\_\_\_\_\_ Ft. from E. Line

660 Ft. from W. Line

		o	

**BEMIS POOL**

Location \_\_\_\_\_

Rig up \_\_\_\_\_

Drilling and Remarks:

*P.B. 3628  
500 mid  
750 "*

*pot. 69 bbls.*

**RECORD**

Cased \_\_\_\_\_ in. \_\_\_\_\_ ft.

Sand *Arbuckle 3597*

Gas \_\_\_\_\_

Oil \_\_\_\_\_

Total Depth *3631*

**PRODUCTION**

1st 24 hrs. Nat. \_\_\_\_\_

1st 24 hrs. after shot \_\_\_\_\_

Gas \_\_\_\_\_ Cu. Ft.

Dry Hole \_\_\_\_\_

Abandoned \_\_\_\_\_

Date

APR 10 1940 19

S. J. LEWIS Scout

Misc Small *RAM*  
Cards *RAM*  
Tracing *RAM*  
France Map *RAM*  
Scarborough Map *RAM*  
Moody Map  
Geological Dept.  
Moody Flat Book

County Ellis State Kansas

Sec. 32 (Blk. Twp.) 11 (Sur. Rge.) 17W Map No.

Operator Barnett et al.

Well No. 1 Farm Schutts

Elev. \_\_\_\_\_ Location C N/2 NW NE


FIRST REPORT  
ABANDONED

330 Ft. From N Line NE

660 Ft. From W Line Quarter

Ist. Report MAR 5 1952

Completion MAR 5 1962

Remarks OWPB

Spudding Date O. W. P. B.

Drlg. Data

Topeka 3070 Lans 3325 Simp 3595 Arb 3597

OTD 3631 was arb prod. - PB 3439 12/3418-22

NS PB 3403 12/3397-3401 500A  $\frac{1}{2}$ Bo plus 3

BWPH for 9 hrs. PB 3388 23/3377-84 500A

$\frac{1}{2}$  Bo plus 4 BWPH D&A

**J. G. McGEHEE**

36

Scout Card	.....
Land Small	.....
Land Wall M.	.....
Tracings	.....
Francis Map	.....
Pierce Map	.....
Misc.	.....

*W*

*33*

35  
MAR 7 1952

Orig. Data