

KANSAS

Section 32 Township 11 Range 20WWell No. 1 KeagyCompany Sohio & VeederWildcat
NORTH

0								

WEST

EAST

SOUTH

12

Ellis

KANSAS



Sec. 32 Twp. 11 R. 20W

Well No. #1 Keagy Farm

Sohio & Veeder Company

(Veeder, Cont.)

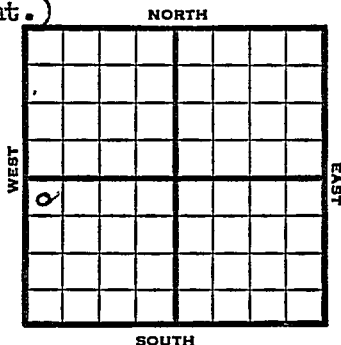
330' Ft. from N. Line

 Ft. from S. Line

 Ft. from E. Line

330' Ft. from W. Line

NW SW



1949

Elev 2195' REPORT

7/27

Location

8/3

"

8/10

8" @ 537'

Drlg 2446'

8/17

Lansing 3506'

BKG 3749'

Drlg 3774'

8/24

TD 3900'

Arb. 3867'

Aband.

ABANDONED

Kansas

Wildcat

Map No. _____ Sec. 32 Twp. 11 R. 20WWell No. 1 Keagy

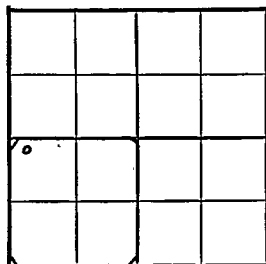
Sohio & Veeder

Company

Veeder

Contractor

NW SW

FIRST REPORT
SECTION PLAT330 Ft. from N. Line Ft. from S. Line Ft. from E. Line330 Ft. from W. Line

Ellis County

Location ✓Rig up Drilling and Remarks:

RECORD

Cased in., ft.Sand Gas Oil Total Depth

PRODUCTION

1st 24 hrs. Nat. 1st 24 hrs. after shot Gas Cu. Ft.Dry Hole Abandoned

Date

JUL 27 1949 19S. J. LEWIS

Scout

Map No. _____ Sec. 32 Twp. 11 R. 20W

Well No. 1 Keagy

Sohio & Veeder Company

~~CORRECTION~~ *correction* Contractor

NW SW

SECTION PLAT

330 Ft. from N. Line

_____ Ft. from S. Line

_____ Ft. from E. Line

330 Ft. from W. Line

o			

Ellis County

Location _____

Rig up _____

Drilling and Remarks:

Reported
 85-11-20W

RECORD

Cased _____ in., _____ ft.

Sand _____

Gas _____

Oil _____

Total Depth _____

PRODUCTION

1st 24 hrs. Nat. _____

1st 24 hrs. after shot _____

Gas _____ Cu. Ft.

Dry Hole _____

Abandoned _____

Date

AUG 3 1949

19

S. J. LEWIS

Scout

Kansas

Map No. K70 Sec. 32 Twp. 11 R. 20WWell No. 1 Keagy

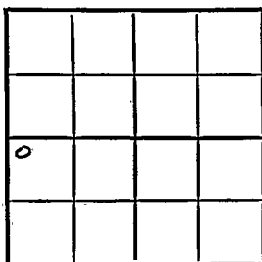
Sohio & Veeder

Company

ABANDONED

Contractor

NW SW

E. 12/95
SECTION PLAT330 Ft. from N. Line Ft. from S. Line Ft. from E. Line330 Ft. from W. Line

Ellis County

RECORD

Location Cased in., ft.Rig up Sand

Drilling and Remarks:

Gas Oil Total Depth 3911

PRODUCTION

1st 24 hrs. Nat. 1st 24 hrs. after shot Gas Cu. Ft. Dry Hole Abandoned cut 3867

Date

AUG 24 1949 19S. J. LEWIS

Scout