


KANSAS

Section 32 Township 11 Range 24W

Well No. #1 Schwanbeck

Company Aurora Gasoline

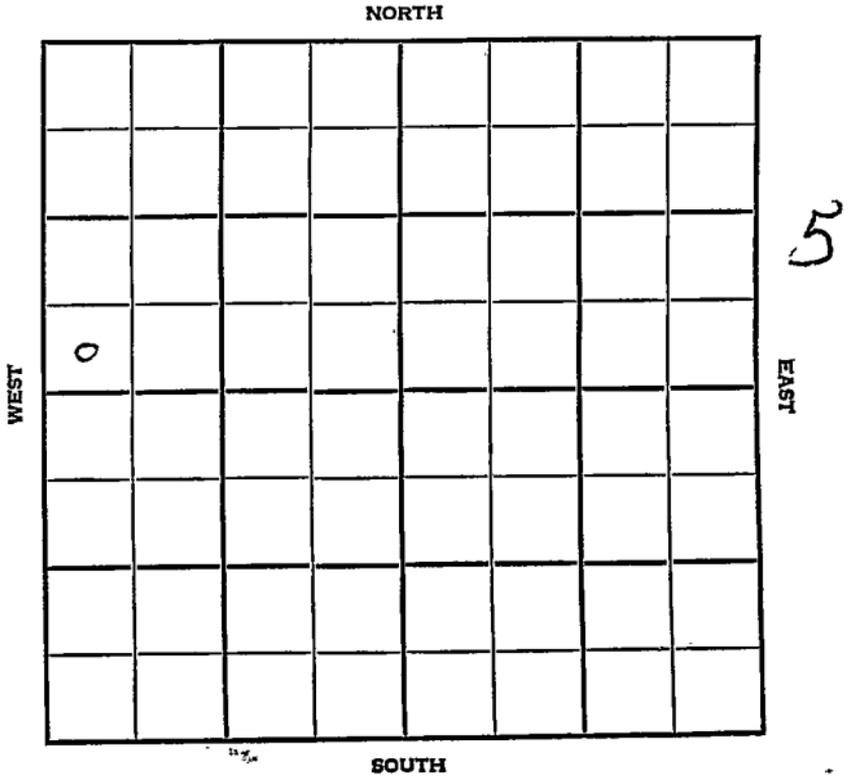

Trego KANSAS

SEC.	TWP.	R.
32	11	2/W

WELL NO. **1 Schwanbeck** FARM

COMPANY **Aurora Gasoline**


CONTRACTOR **Veeder Wildcat**

\_\_\_\_\_ Ft. from N. Line

**330** \_\_\_\_\_ Ft. from S. Line

\_\_\_\_\_ Ft. from E. Line

**330** \_\_\_\_\_ Ft. from W. Line

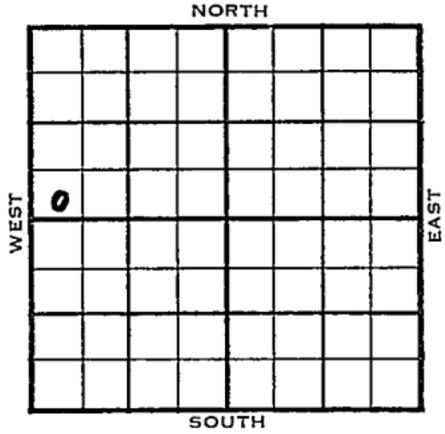

SW SW NW

1955	ELEVATION	REPORT
------	-----------	--------

4/13 Location

County Trego State Kansas

Sec. 32 (Blk. Twp.) 11 (Sur. Rge.) 24W Map No.

Operator Aurora Gasoline

Well No. 1 Farm Schwanbeck

Elev. Location SW SW NW


330 Ft. From S Line NW

330 Ft. From W Line Quarter

1st. Report APR 13 1955

Completion

Remarks

Veeder - Contr.

Spudding Date

Drlg. Data Wildcat

Location

FABEN GILSTRAP