


Section 32 Township 11 Range 23W

Well No. 1 Hixson

Company Aurora Gas & Davis Bros.

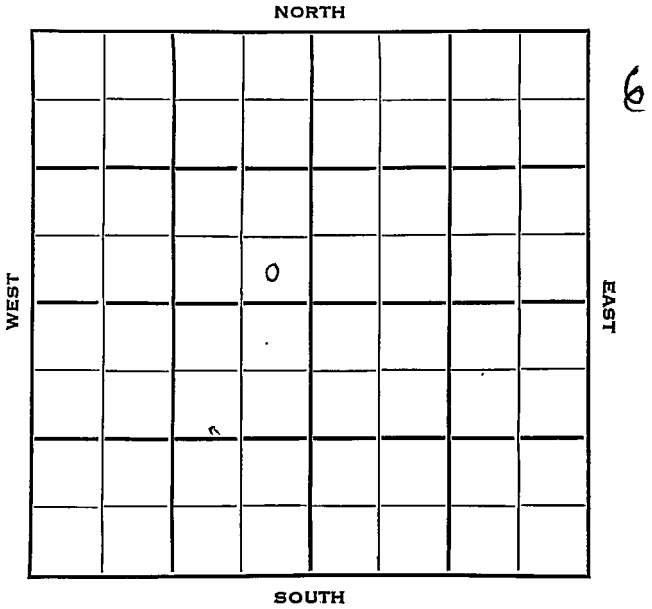

Sec. 32 Twp. 11 R. 23W

Well No. 1 Hixson Farm

Aurora Gas & Davis Bros. Company

Keating - Contr. Contractor

Wildcat

Ft. from N. Line

330


Ft. from S. Line

330

Ft. from E. Line

Ft. from W. Line

SE SE NW

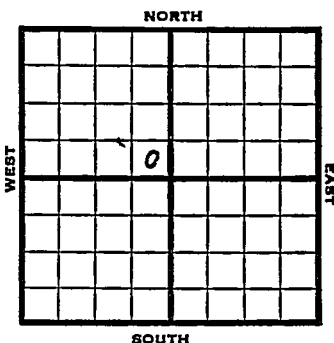

1953 Elev. 2419' REPORT

4/1 M I M  
 4/16 Anhy 1925, <sup>T</sup>op 3547, Heeb 3750, Lans 3792  
 DST 3929-47, 1/2 hrs., 15' M 970#  
 DST 3946-4005, 1/2 hrs., 10' M  
 Drlg. 4065'  
 4/23 Miss 4376, Miss Dol 4389  
 DST 4170-88, 3/4 hrs., 7' SOCM 250#  
 Simp 4434, Arb 4508  
 RTD 4530  
 4/29 <sup>u</sup>pud 4-2-53  
 D&A  
 TD 4530  
 8" @ 178  
 Anhy 1925, <sup>T</sup>op 3547, Heeb 3750, Lans 3792  
 DST 3929-47, opn 1/2 hrs., rec. 15' mud 970#  
 DST 3946-4005, opn 1/2 hrs., rec. 10' mud, 0#  
 Miss 4376, Miss dol. 4389  
 DST 4170-88, opn 3/4 hrs., rec. 7' socm 250#  
 Simp. 4434, Arb. 4508  
 TD 4530  
 D&A

**ABANDONED**

County Trego State Kansas

Sec. 32 (Blk. Twp.) 11 (Sur. Rge.) 23W Map No.

Operator Aurora Gas & Davis Bros.

Well No. 1 Farm Hixson

Elev. Location SE SE NW

		0			

330Ft. From S Line NW

330Ft. From E Line Quarter

1st. Report APR 1 1953

Completion

Remarks

Leating - Contr.

Spudding Date

Drlg. Data Wildcat

M I M

