

Well No. 3 Booth Farm

Snowden & Mc Sweeney Company

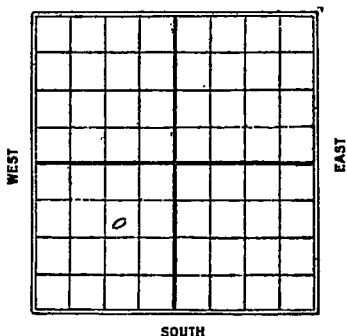
NORTH

990 Ft. from N. Line

-----Ft. from S. Line

990 Ft. from E. Line

-----Ft. from W. Line

[illegible]

Wm. Russell
 Map No. **KANSAS** Sec. *32* Twp. *11* R. *15N*

Well No. *3, Booth*

Snowden & McSweeney Company
 Contractor

SECTION PLAT

990 Ft. from N. Line

_____ Ft. from S. Line

990 Ft. from E. Line

_____ Ft. from W. Line

FIRST REPORTS

Location _____

Rig up _____

Drilling and Remarks:

Loc.

RECORD

Cased _____ in., _____ ft.

Sand _____

Gas _____

Oil _____

Total Depth _____

PRODUCTION

1st 24 hrs. Nat. _____

1st 24 hrs. after shot _____

Gas _____ Cu. Ft.

Dry Hole _____

Abandoned _____

3 1926

192

S. J. LEWIS

Scout

Map No. KANSAS Sec. 32 Twp. 11 R. 16WWell No. 3 BoothSnowden & McSweeney Company
Contractor

SECTION PLAT

990 Ft. from N. Line

----- Ft. from S. Line

990 Ft. from E. Line

----- Ft. from W. Line

COMPLETED

Location -----

Rig up -----

Drilling and Remarks:

Sand
2875-2884200 ft.

RECORD

Cased ----- in., ----- ft.

Sand -----

Gas -----

Oil -----

Total Depth -----

PRODUCTION

1st 24 hrs. Nat. -----

1st 24 hrs. after shot -----

Gas ----- Cu. Ft.

Dry Hole -----

Abandoned -----

Date

JUN 23 1926S. J. LEWIS

Scout