


Ellis KANSAS  
11 Range 16W

Section 33 Township \_\_\_\_\_

Well No. 1 Chrisler

Company Heathman & Co.

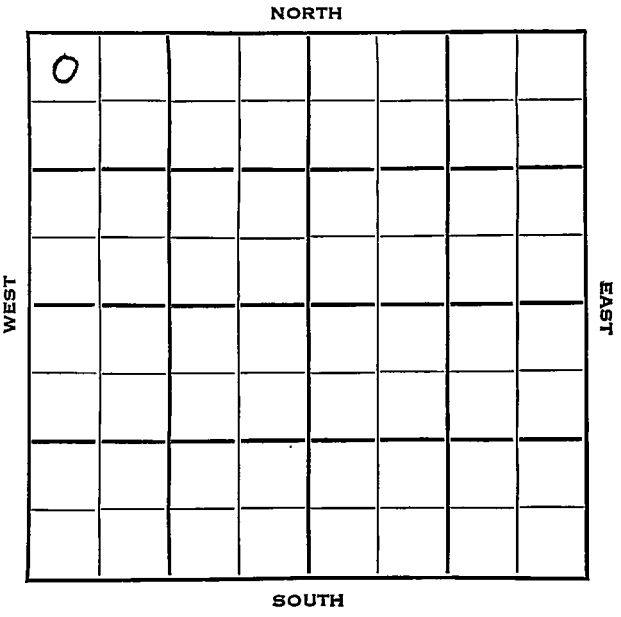

Ellis

KANSAS



Sec. 33 Twp. 11 R. 16 W

Well No. # 1 Chrisler Farm

Heathman & Co. Company

Strain Drlg. Contractor

Wildcat


330 Ft. from N. Line

Ft. from S. Line

Ft. from E. Line

330 Ft. from W. Line

NW NW NW

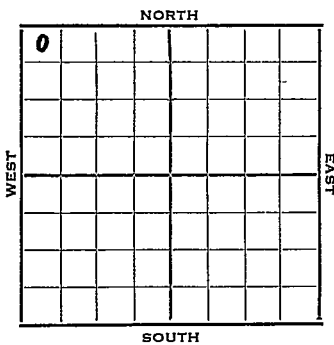

1953

Elev. 1825' REPORT

7/29

Spud 7-21-53  
8" @ 754 Anhy 992'  
Drlg. 2635'

8/5

Spud 7-21-53  
D&A  
TD 3433  
8" @ 754, Top 2756, Heeb 3000, Tor 3022,  
Lans 3047, B KC 3271  
DST 3330-65, opn 1 hr., rec. 35' wcm,  
880#  
Cong 3337, Arb. 3423  
TD 3433  
D&A

ABANDONED

County Ellis State Kansas

Sec. 33 (Blk.) 11 (Sur.) 16W Map No.

Operator Heathman & Co.

Well No. 1 Farm Chrisler

Elev. 1825 Location NW NW NW

0				

330 Ft. From N Line NW

330 Ft. From W Line Quarter

1st. Report JUL 20 1953

Completion .

Remarks

Strain Drlg. - Contr.

Spudding Date 7-21-53

Drig. Data Wildcat

8" @ 754 Anhy 992 drlg. 2635

County Ellis State Kansas  
 Sec. 33 (Blk. 11) (Sur. 16W) (Twp.) (Rge.) Map No.  
 Operator Heathman & Co.  
 Well No. 1 Farm Chrisler  
 Elev. 1825 Location NW NW NW

0				

**ABANDONED**

330 Ft. From N Line NW  
330 Ft. From W Line Quarter  
 Ist. Report  
 Completion AUG 5 1953  
 Remarks Wildcat  
Strain Drlg. - Contr.  
 Spudding Date 7-21-53

Drlg. Data D & A TD 3433  
8" @ 754 Anhy 992 Top. 2756  
Heeb. 3000 Tor. 3022 Lans. 3047  
B KC 3271 DST 3330-65 open 1 hr.  
Rec. 35' wcm 880# Cong. 3337  
Arb. 3423 TD 3433

D & A

J. G. McGEHEE