

# KANSAS


FORM 51 5M 1-42 PETROL

Russell

Section 33 Township 11  
~~12~~ Range 15-W

Well No. #1 Eulert

Company Saco Oil

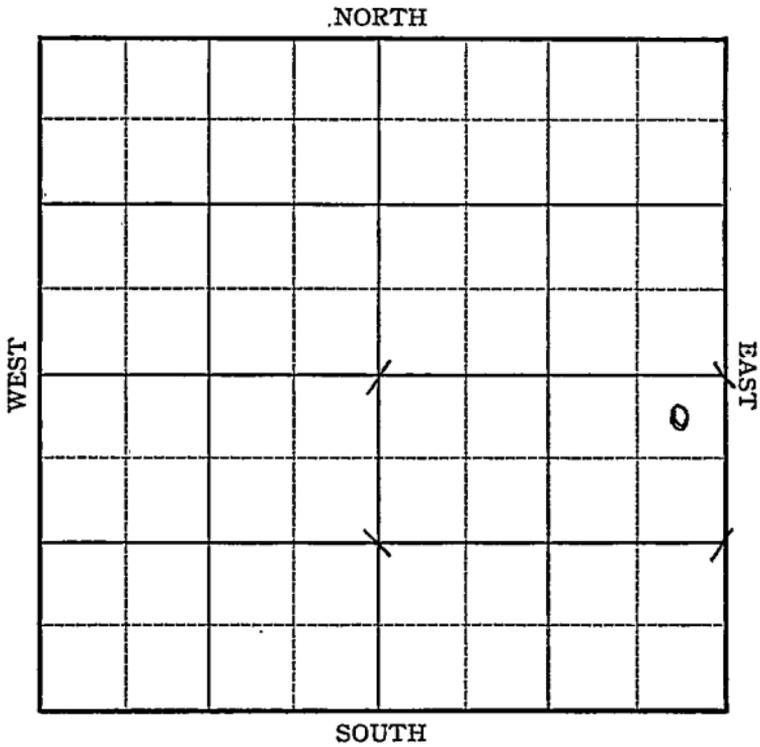

Sec. 33 Twp. 11  
12 R. 15-W

Well No. #1 Eulert Farm

Saco Oil Company

Wildcat


330 Ft. from N. Line

\_\_\_\_\_ Ft. from S. Line

330 Ft. from E. Line

\_\_\_\_\_ Ft. from W. Line

*Elev. 1784*

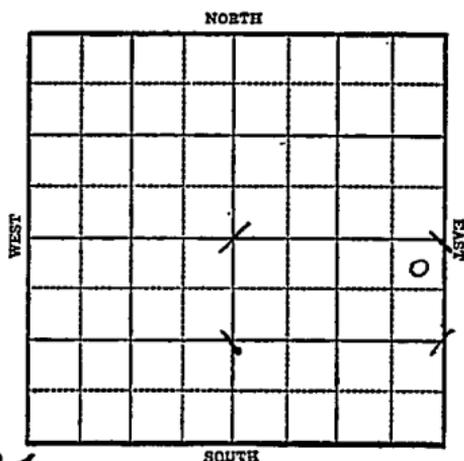

1943

R E P O R T

5/26	Cellar
6/9	"
6/16	Cable rig
6/23	" "
6/30	" "
7/7	Spud 190'
7/15	15" @ 374' Drlg. 520
7/21	Drlg. 1570' 10 @ 873'
7/28	2130' fsg bailer
8/4	2398' Run 8"
8/11	Fsg
8/18	"
8/25	8" @ 2301 T.D. 2433 UR 8"

**OVER**

1943

9/1 Drlg. 2650'

9/8 8" @ 2650

KC 2952

Drlg. 3075

9/15 Arb 3285'

HFW

T.D. 3310'

**ABANDONED**

Russell

Map No. KANSAS Sec. 33 Twp. 12 R. 15W

Well No. 1 Eulert

Saco Oil Company

FIRST REPORT Contractor

NE SE


SECTION PLAT

330 Ft. from N. Line

\_\_\_\_\_ Ft. from S. Line

330 Ft. from E. Line

\_\_\_\_\_ Ft. from W. Line

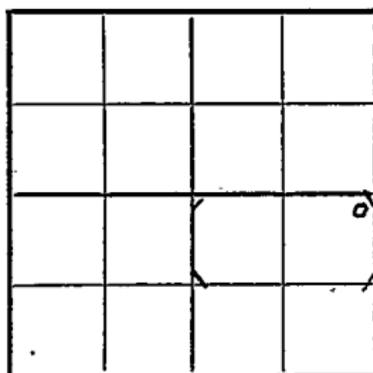

WILDCAT

Location \_\_\_\_\_

Rig up \_\_\_\_\_

Drilling and Remarks:

Cellar

RECORD

Cased \_\_\_\_\_ in., \_\_\_\_\_ ft.

Sand \_\_\_\_\_

Gas \_\_\_\_\_

Oil \_\_\_\_\_

Total Depth \_\_\_\_\_

PRODUCTION

1st 24 hrs. Nat. \_\_\_\_\_

1st 24 hrs. after shot \_\_\_\_\_

Gas \_\_\_\_\_ Cu. Ft.

Dry Hole \_\_\_\_\_

Abandoned \_\_\_\_\_

Date

MAY 26 1943 19

S. J. LEWIS Scout

Russell

KANSAS 72 Sec. 33 Twp. 11 R. 15W  
 Map No. \_\_\_\_\_

Well No. 1 Eulert

Saco Oil Company

CORRECTION Contractor

NE SE

SECTION FLAT

330 Ft. from N. Line

\_\_\_\_\_ Ft. from S. Line

330 Ft. from E. Line

\_\_\_\_\_ Ft. from W. Line


WILDCAT

Location \_\_\_\_\_

Rig up \_\_\_\_\_

Drilling and Remarks:

RECORD

Cased \_\_\_\_\_ in., \_\_\_\_\_ ft.

Sand \_\_\_\_\_

Gas \_\_\_\_\_

Oil \_\_\_\_\_

Total Depth \_\_\_\_\_

Reported

33-12-15W

PRODUCTION

1st 24 hrs. Nat. \_\_\_\_\_

1st 24 hrs. after shot \_\_\_\_\_

Gas \_\_\_\_\_ Cu. Ft.

Dry Hole \_\_\_\_\_

Abandoned \_\_\_\_\_

Date

JUN 2 1943

S. J. LEWIS

Scout

**KANSAS**Map No. 72 Sec. 33 Twp. 11 R. 15WWell No. 1 EulertSaco Oil

Company

ABANDONED

Contractor

NE SE

SECTION PLAT

330

Ft. from N. Line

Ft. from S. Line

330

Ft. from E. Line

Ft. from W. Line

			o

Wildcat

Location \_\_\_\_\_

Rig up \_\_\_\_\_

Drilling and Remarks:

*Cer 8 3285*  
*NFA*

RECORD

Cased \_\_\_\_\_ in., \_\_\_\_\_ ft.

Sand \_\_\_\_\_

Gas \_\_\_\_\_

Oil \_\_\_\_\_

Total Depth 3310

PRODUCTION

1st 24 hrs. Nat. \_\_\_\_\_

1st 24 hrs. after shot<sup>1</sup> \_\_\_\_\_

Gas \_\_\_\_\_ Cu. Ft.

Dry Hole \_\_\_\_\_

Abandoned \_\_\_\_\_

Date

SEP 15 1943

19

S. J. LEWIS

Scout