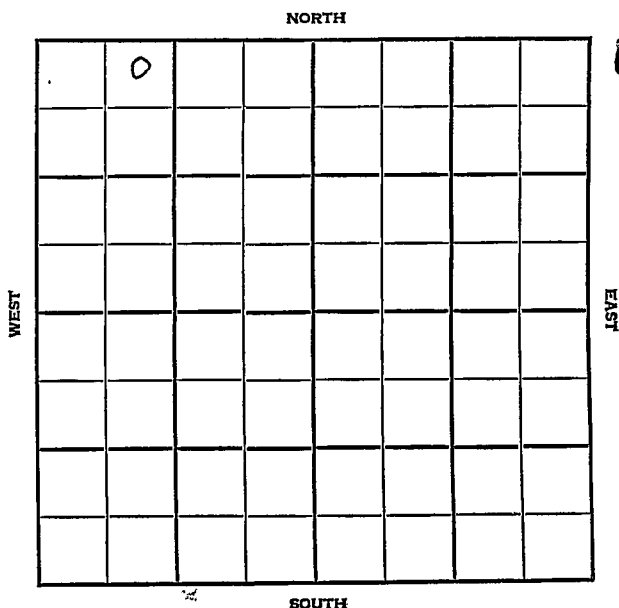


Section 33 Township 11 Range 18 WWell No. #1 Wm. JohnsonCompany Sunray Mid-Continent Oil Co.

HOT FILE		Ellis	KANSAS
SEC.	TWP.	R.	
33	11	18W	
WELL NO.			
I Wm. Johnson			FARM
COMPANY			
Sunray Mid-Continent Oil Co. (DEVELOP- MENT)			
CONTRACTOR			

Stickle

SW Burnett

330 _____ Ft. from N. Line


_____ Ft. from S. Line

_____ Ft. from E. Line

1190' _____ Ft. from W. Line

of NW/4

NE NW NW

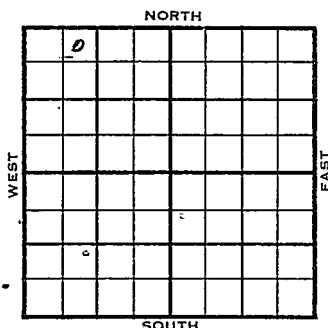

	ELEVATION	REPORT
1955		
8/24	Location	(F.R. TKT)
8/29	Spud 8-27-55	
	Prep to run 8-5/8" csg.	
	Drlg. 1391'	(DR #169)
	(Moved 200' East of original spot because of terrain.)	
8/30	TD 1391'. WOC - 8-5/8" @ 1388'	
8/31	Drlg. 1500'	
9/1	Drlg. 2265'	
9/2	Drlg. 2650'	
9/6	Drlg. 3465'.	
	DST #1, 3405-28', 1 hr, weak blow, rec 5' oil cut mud, 30' slightly oil cut salt wtr. FP 60#. SIP 100#	
9/7	Drlg. 3530'.	
	DST #2, 3510-19', 1 hr, faint blow 3 min, rec 7' drlg. mud. FP 30#. SIP 40#.	
9/8	TD 3630' Pulling - DST #3, 3612-30 1 hr, weak blow for 3 min.	
9/9	Coring @ 3650'. No rec shown for DST#3	
9/12	TD 3661'. DST #4, 3627-61, 1½ hrs, fair blow, rec 100' slightly water cut mud w/specks of oil, 65' muddy SW. FP 180#. BHP 1030# P & A 9-11-55	

OVER

~~9-8~~ Heeb. 3299,
Eans. 3342

~~For. 3322~~

9/14

Comm. 8-26-55

8-5/8" @ 1388 w/1000 sax.

DST 3405-28, open 1 hr rec 5' OCM
plus 30' VOS & SWCM, BHP 100# 20"

DST 3510-19, open 1 hr rec 7' DM
BHP 40# 30"

DST 3612-30, rec 7' DM, specks oil
BHP 190# 30"

DST 3627-61, open 1½ hr rec 100' SCM
(w/spks heavy blk oil) + 65' MCSW

BHP 1030# 60" RTD 3661' Ran log.

D & A. TD 3661'

Tops: Anh 1381', H. 3299', Tr. 3322'

L. 3342', A. 3623'

LOG: H. 3300', Tr. 3319', L. 3343'

BKG 3575', A. 3620'

ABANDONED

AUG 29 1955

Scout Cards	<u>mm^c</u>
Land Small Map	<u> </u>
Land Wall Map	<u> </u>
Tracings	<u> </u>
France Map	<u> </u>
Pierce Map	<u> </u>
Misc.	<u> </u>

County ELLIS Elev. 2081 DF
 Sec. 33 Twp. 11S Rge. 18W
 Company Sunray Mid-Cont. Oil Co.
 Farm Name Wm. Johnson No. 1

TOPS	DEPTH	LOG	DATUM	Loc. in Sec.
Anh.	1381			NE NW NW
Tr.	3299	3300	1219	1190' WL
Dg.	3322	3319	1238	
BL.				
L.	3342	3343	1262	Geol.
K.C.				Contr.
B.K.C.		3575	1494	
Ce.				Stickle
C.				
M.				Pool
M.				SW Burnett
K.				
Mz.				
Me.				
V.				
S.				
S.				
A	3623	3620	1539	ABANDONED
R.				
Pe.				
G.				
T.D.	3661			

Date Comm. 8-26-55 SEP 14 1955

8-5/8" 1388 w/1000 sx; DST 3405-28 op

1 hr. rec. 5' ocm plus 30' vos and swcm,

BHP 100# 20"; DST 3510-19 op 1 hr. rec. 7'

dm, BHP 40# 30"; DST 3612-30 rec. 7' dm,

specks oil BHP.190# 30"; DST 3627-61 op

1½ hr. rec. 100' scm (w/spks heavy blk oil)

65' mcs w, BHP 1030# 60"; RTD 3661;

ran log; D & A

SEP 21 1955

Scout Cards *mm*
Land Small Map
Land Wall Map
Tracings
France Map
Pierce Map
Misc.