

KANSAS


FORM 51 5M 6-46 PETROL

Ellis county

Section 33 Township 11 Range 17-W

Well No. #7, Bemis "F"

Company Sohio and Lario

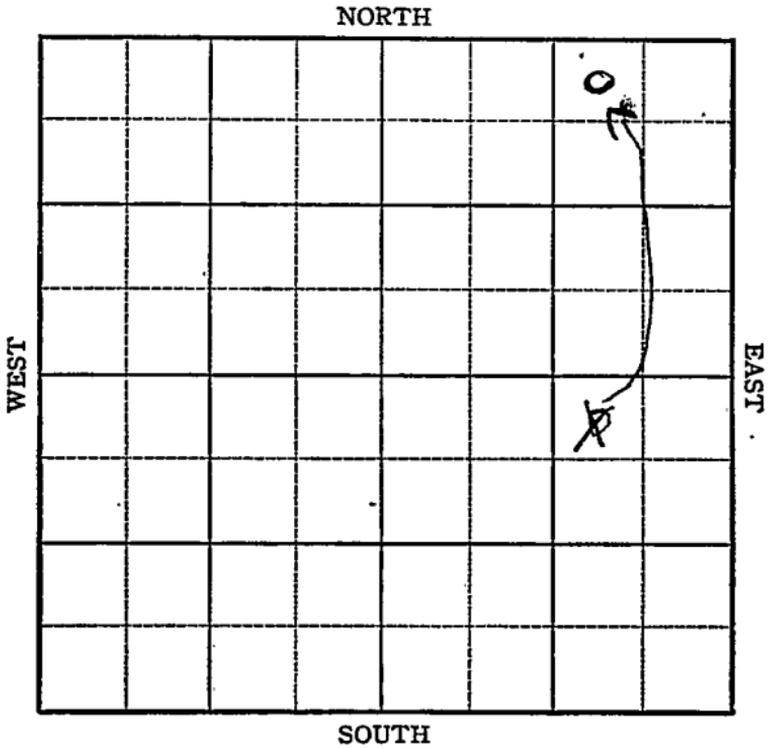

KANSAS

Ellis County

Sec. 33 Twp. 11 R. 17W

Well No. #7 Bemis "F" Farm

Sohio & Lario Company

Bemis

330 Ft. from N. Line


Ft. from S. Line

990 Ft. from E. Line

Ft. from W. Line

NW NENE

~~NW NE SE~~

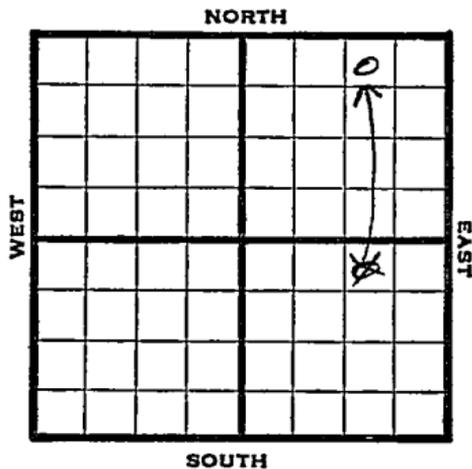

1946 2083

REPORT

9/25 Location

10/1 13" @ 60' WOC

10/8 Anhy 4297  
8" @ 1307'  
Drlg 1945'

10/15 Drlg 3305'

10/22 Arb 3585'  
TD 3586'  
5" @ 3 585', RUST

10/29 TD 3592'  
Swb 6 oil PH 5 hrs

11/6 " "

11/12 " "

11/20 " "

11/27 Arb 3585'  
5" @ 3585'  
TD 3592'  
Pump 149 POT  
36 Grav.

COMPLETED

**KANSAS** Kansas Pool Name Bemis

Map No. 7/ Sec. 33 Twp. 11 R. 17W

Well No. 7 Bemis "F"

Sohio & Lario Company

**FIRST REPORT** Contractor

NW NE SE

**SECTION PLAT**

			o

330 Ft. from N. Line

\_\_\_\_\_ Ft. from S. Line

990 Ft. from E. Line

\_\_\_\_\_ Ft. from W. Line

Ellis County

Location X

Rig up \_\_\_\_\_

Drilling and Remarks:

**RECORD**

Cased \_\_\_\_\_ in., \_\_\_\_\_ ft.

Sand \_\_\_\_\_

Gas \_\_\_\_\_

Oil \_\_\_\_\_

Total Depth \_\_\_\_\_

**PRODUCTION**

1st 24 hrs. Nat. \_\_\_\_\_

1st 24 hrs. after shot \_\_\_\_\_

Gas \_\_\_\_\_ Cu. Ft.

Dry Hole \_\_\_\_\_

Abandoned \_\_\_\_\_

Date

SEP 25 1946 19 \_\_\_\_\_


S. J. LEWIS Scout

KANSAS Kansas Pool Name Bemis  
 Map No. 7/ Sec. 33 Twp. 11 R. 17W  
 Well No. 7 Bemis "F"

Sohio & Lario Company  
CORRECTION Contractor

NW NE NE

SECTION PLAT

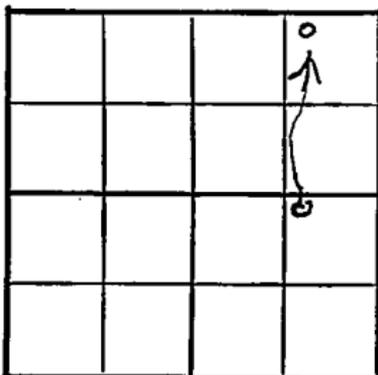

330 Ft. from N. Line  
 \_\_\_\_\_ Ft. from S. Line  
990 Ft. from E. Line  
 \_\_\_\_\_ Ft. from W. Line

Ellis County

Location \_\_\_\_\_

Rig up \_\_\_\_\_

Drilling and Remarks:

Reported

NW NE SE

RECORD

Cased \_\_\_\_\_ in., \_\_\_\_\_ ft.

Sand \_\_\_\_\_

Gas \_\_\_\_\_

Oil \_\_\_\_\_

Total Depth \_\_\_\_\_

PRODUCTION

1st 24 hrs. Nat. \_\_\_\_\_

1st 24 hrs. after shot \_\_\_\_\_

Gas \_\_\_\_\_ Cu. Ft.

Dry Hole \_\_\_\_\_

Abandoned \_\_\_\_\_

Date

OCT 2 1946

S. J. LEWIS Scout

Map No. 71 Sec. 33 Twp. 11 R. 17W

Well No. 7 Bemis "F"

Sohio & Lario Company

**COMPLETED**

Contractor

NW NE NE

*E, 2083*  
SECTION PLAT

330 Ft. from N. Line

         Ft. from S. Line

990 Ft. from E. Line

         Ft. from W. Line

			o

Ellis County

Location \_\_\_\_\_

Rig up \_\_\_\_\_

Drilling and Remarks:

*Cut 3585  
5" 3585  
Pump 149.5 ft*

*26° E*

**RECORD**

Cased \_\_\_\_\_ in., \_\_\_\_\_ ft.

Sand \_\_\_\_\_

Gas \_\_\_\_\_

Oil \_\_\_\_\_

Total Depth 2592

**PRODUCTION**

1st 24 hrs. Nat. \_\_\_\_\_

1st 24 hrs. after shot \_\_\_\_\_

Gas \_\_\_\_\_ Cu. Ft.

Dry Hole \_\_\_\_\_

Abandoned \_\_\_\_\_

Date

NOV 27 1946

19

S. J. LEWIS

Scout