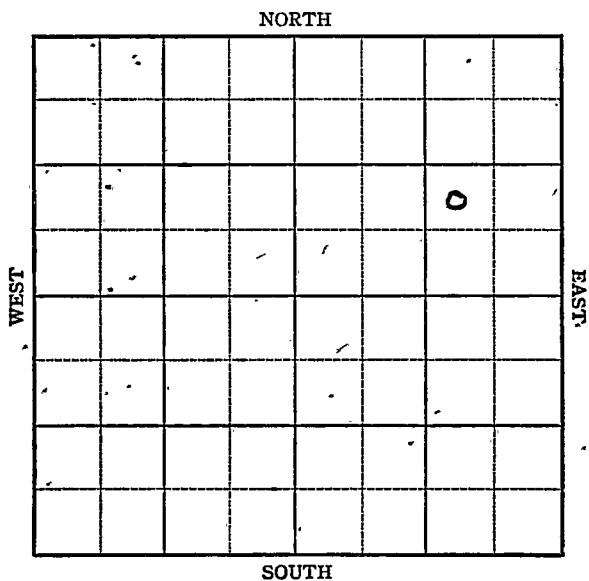


KANSAS

Ellis county

Section 33 Township 11 Range 17-WWell No. #9, Bemis "F"Company Sohio etal

KANSAS

Ellis county

Sec. 33 Twp. 11 R. 17-W

Well No. #9, Bemis "F" Farm

Sohio etal Company
Bemis Pool


 Ft. from N. Line

990' Ft. from S. Line

990' Ft. from E. Line

 Ft. from W. Line

NW SE NE

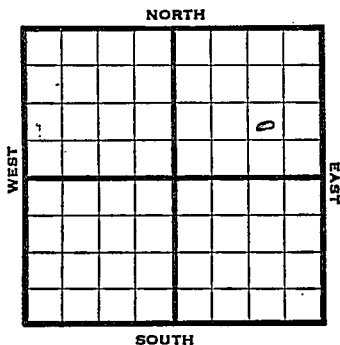

1947	Elev. 2083	REPORT
1/22	Anhy 1298'	
	8" @ 1303'	
	WOC	
1/30	Dr1g 3009'	
2/5	Arb. 3598'	
	TD 3599	
	5" @ 3598'	
	RUST	
2/12	" " "	
2/19	TD 3604'	
	Swb 3 bbls oil	
	PH 4 hrs	
2/26	" "	
3/4	" "	
3/12	Arb 3598'	
	5" @ 3598	
	Pump 195' oil & 4% W Pot	
	Grav. 36	
	TD 3604'	
COMPLETED		

KANSAS

Map No. 71 Sec. 33 Twp. 11 R. 17WWell No. 9 Bemis "F"Sohio et al.

Company

FIRST REPORT

Contractor

NW SE NE

SECTION PLAT

			6

 Ft. from N. Line990 Ft. from S. Line990 Ft. from E. Line Ft. from W. Line

Ellis County

Location Rig up

Drilling and Remarks:

Anhy 1298

8" @ 1303 WOC

RECORD

Cased in., ft.Sand Gas Oil Total Depth

PRODUCTION

1st 24 hrs. Nat. 1st 24 hrs. after shot Gas - Cu. Ft.Dry Hole Abandoned

Date

JAN 22 1947 19

S. J. LEWIS

Scout

Kansas

Map No. 71 Sec. 33 Twp. 11 R. 17WWell No. 9 Bemis "F"

Sohio et al.

Company

COMPLETE

Contractor

NW SE NE

E12523

SECTION PLAT

			0

_____ Ft. from N. Line

990 Ft. from S. Line990 Ft. from E. Line

_____ Ft. from W. Line

Ellis County

Location _____

Rig up _____

Drilling and Remarks:

Core 3578
5-1-2578
Pump 195 oil
F 4% W Port

36 1/2

RECORD

Cased _____ in., _____ ft.

Sand _____

Gas _____

Oil _____

Total Depth 3604

PRODUCTION

1st 24 hrs. Nat. _____

1st 24 hrs. after shot _____

Gas _____ Cu. Ft.

Dry Hole _____

Abandoned _____

Date

MAR 12 1947

19

S. J. LEWIS

Scout