
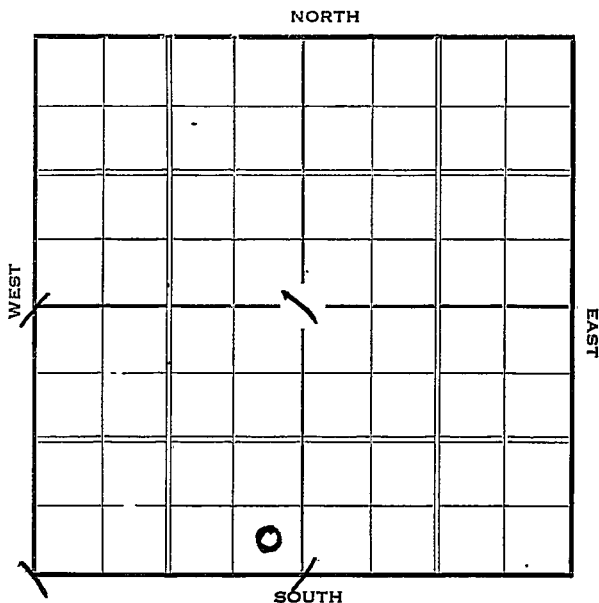


Section 33 Township 11 Range 17-WWell Number #1 BemisCompany McPherson Oily
Wolfe Creek

Sec. 33 Twp. 11 R. 17-WWell No. #1 Bemis Farm~~Well No. 33~~ McPherson Drilling company Ft. from N. Line330 Ft. from S. Line330 Ft. from E. Line Ft. from W. Line

Elev, 2105

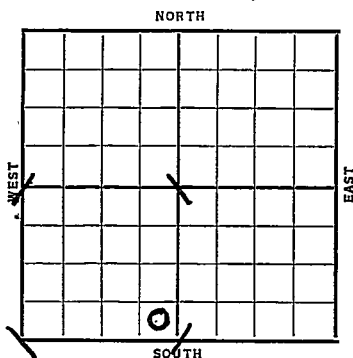

Date

REPORT

1937

6/30

Rig on ground

7/9

Rig.

7/16

"

7/23

"

7/30

"

8/6

"

8/13

R. U.

8/20

15" @ 50'. WOC.

8/28

Drilg. 1134'.

9/3

Drilg. 2754'.

9/10

Drilg. 3210'.

9/17

Simp. 3607-13' Sat Core.

Sil. 3613'. T.D. 3615'.

No shows in Sil.

7" @ 3607'. RUST.

9/24

T.D. 3623'. 2000 acid.

Swabbed 42 bbls. oil per hour
for 3 hrs.

OVER

1937

9/29 7" @ 3607'.

Sil. 3613'.

T.D. 3623'.

2000 acid.

Pot. 1126 bbls.


COMPLETED.

Map No. _____ Sec. 33 Twp. 11 R. 17WWell No. 1 - BernisWolfe Creek Company _____

Contractor _____

FIRST REPORT

SECTION PLAT

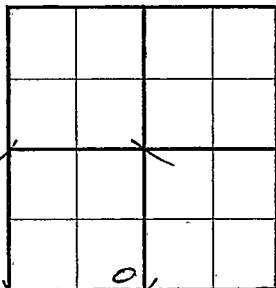

_____ Ft. from N. Line

330 Ft. from S. Line330 Ft. from E. Line

_____ Ft. from W. Line

Dry hole in SW/4 was drilled
 before W-Creek got LEASE

Location _____

Rig up _____

Drilling and Remarks:

R. O. J.

RECORD

Cased _____ in., _____ ft.

Sand _____

Gas _____

Oil _____

Total Depth _____

PRODUCTION

1st 24 hrs. Nat. _____

1st 24 hrs. after shot _____

Gas _____ Cu. Ft.

Dry Hole _____

Abandoned _____


Date

JUN 30 1937 19 H. D. Hatfield Scout

Map No. _____ Sec. 33 Twp. 11 R. 17^WWell No. 1 - BennieMcPherson Drilling Company
Contractor

CORRECTION

SECTION PLAT

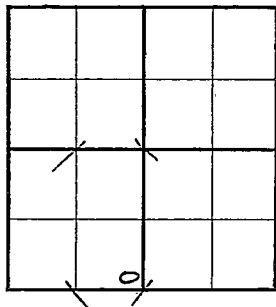11 Ft. from N. Line330 Ft. from S. Line330 Ft. from E. Line

_____ Ft. from W. Line

Location _____

Rig up _____

Drilling and Remarks:

Did belong To Wolfe Creek
but They Turned
IT over To ~~above~~ Co

RECORD

Cased _____ in., _____ ft.

Sand _____

Gas _____

Total Depth _____

PRODUCTION

1st 24 hrs. Nat. _____

1st 24 hrs. after shot _____

Gas _____ Cu. Ft.

Dry Hole _____

Abandoned _____

Date

JUL 14 1937 19

H. D. Hatfield

Scout

Ellis

KANSAS

Map No. _____ Sec. 33 Twp. 11 R. 17WWell No. 1-BemisMcPherson Drig. Company

Contractor

COMPLETED

SE SW

SECTION PLAT

_____ Ft. from N. Line

330 Ft. from S. Line330 Ft. from E. Line

_____ Ft. from W. Line

Location _____

Rig up _____

Drilling and Remarks:

*2000 acid**Pot- 1126*

RECORD

Cased 7 in., 3607 ft.Sand 51 3613

Gas _____

Oil _____

Total Depth 3623

PRODUCTION

1st 24 hrs. Nat. _____

1st 24 hrs. after shot _____

Gas _____ Cu. Ft.

Dry Hole _____

Abandoned _____

Date

SEP 29 1937

19

D. Hatfield Scout