

Ellis

Form 252-A
5M 4-32 MPC

Map No. KANSAS Sec. 33 Twp 11 R. 17^w

Well No. 1 - Bemis Farm

Phillips Pet Company


 Ft. from N. Line

440 Ft. from S. Line

 Ft. from E. Line

440 Ft. from W. Line

1932

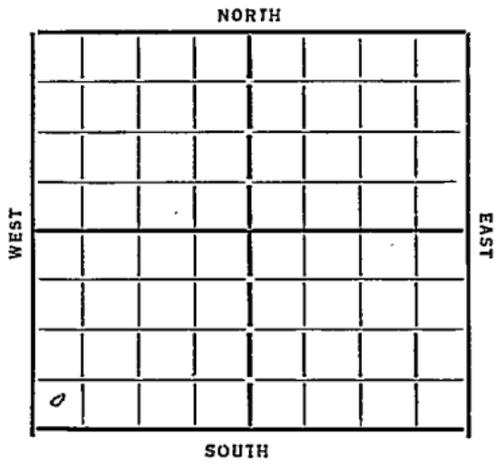

Date	REPORT
11/30	Bldg rotary rig
12/7	RUR
12/14	—
12/21	Drelg 2200'
12/28	" 2780'
1933	—
174	" 3184'
1/11	TD 3218' fishing
1/18	TD 3218'
	Will skid rig
1/25	Cemo 20" - 226' (New hole)
2/11	Drelg 2055'
2/8	" 2450'
2/15	by Oswald 3242
	" 8" - 3244
2/22	—
3/4	Show oil 3274 - 6" lined 3280
	Show oil 3338 dly 3340
3/8	St Resuming 6" T.D. 3400
3/15	6" 3419 Small show oil 3440-50'
	Drelg 3481
	(over)

3/22 4 Batters Water 3600-03
I.D. 3606 - 4.9.6"

3/29 - 6" 3605' C.O. 3606

4/4 Top Siliceous 3565'
N.F.W. 3610' - 6" 3505'
abandoned

71 *Ellis*
 Map No. **KANSAS** Sec. *33* Twp. *11* R. *17* ^W

Well No. *1 Bemis*

Phillips pet Co Company
 Contractor

FIRST REPORTS

..... Ft. from N. Line

440 Ft. from S. Line

..... Ft. from E. Line

440 Ft. from W. Line

SECTION PLAT

Location.....

Rig up.....

Drilling and Remarks:

Blay Rod Rig

RECORD

Cased..... in., ft.

Sand.....

Gas.....

Oil.....

Total Depth.....

PRODUCTION

1st 24 hrs. Nat.....

1st 24 hrs. after shot.....

Gas..... Cu. Ft.

Dry Hole.....

Abandoned.....

Date

NOV 2 1932

192

CHAS. L. SHERWOOD
 Scout

Ellis

71 **KANSAS** W
 Map No. _____ Sec. 33 Twp. 11 R. 17

Well No. 1 *Bemis*
Phillips Petroleum Co Company
 _____ Contractor

COMPLETED

_____ Ft. from N. Line
440 Ft. from S. Line
 _____ Ft. from E. Line
440 Ft. from W. Line

SECTION PLAT

ABANDONED

Location _____
 Rig up _____
 Drilling and Remarks:

Top Oilaceous
3565'

HFW 3610

RECORD

Cased 6 in., 3605 ft.
 Sand _____
 Gas _____
 Oil _____
 Total Depth 3617 1/2

PRODUCTION

1st 24 hrs. Nat. _____
 1st 24 hrs. after shot _____
 Gas _____ Cu. Ft.
 Dry Hole
 Abandoned

Date

APR 5 1933

CHAS. L. SHERWOOD
 192 _____ Scout

Returned	
Cards	<i>MB</i>
Tracing	<i>AK</i>
France Map	<i>T</i>
Scarborough Map	<i>X</i>
Moody Map	<i>X</i>
Scarborough Plat Book	
Moody Plat B.	

no wood

small map

11