


FORM 51 Ellis

Section 33 Township 11 Range 19W

Well No. #3 Solomon

Company Flourney Drlg.

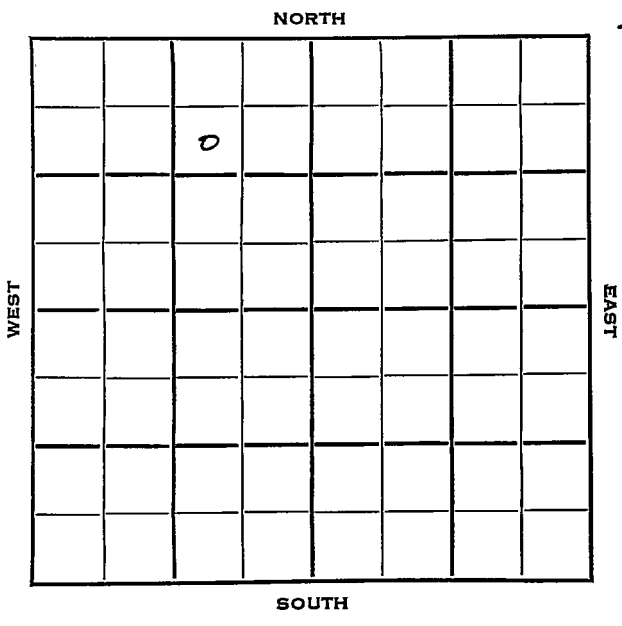

Ellis

KANSAS ✓

Sec. 33 Twp. 11 R. 19W

Well No. ~~#2~~ ^{#3} Solomon Farm

Flourney Drlg. Company

Nye Contractor


990 Ft. from N. Line

_____ Ft. from S. Line

990 Ft. from E. Line

_____ Ft. from W. Line

SW NE NW

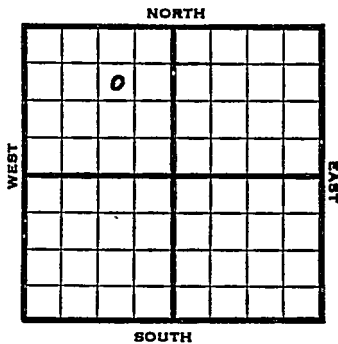

1953 Elev. 2111 REPORT

1/14 Spud 1-11-53
8" @ 108

1/22 Anhy 1426'
Drlg. 3328'

1/29 NR

2/5 Lans. 3343' Arb. 3638' RTD 3645'
4" @ 3643 CO 3645' FU 1100' oil
12 hrs. 250 A POP

2/12 NR

2/18 Spudding Date 1/11/53
Oil Well TD 3645
8" @ 108 Anhy 1426 Lans. 3343
Arb. 3638 TD 3645 4" @ 3643
CO to 3645 FU 1100' oil 12 hr.
250 A
Comp. 81 bopd

COMPLETED

County Ellis State Kansas

Sec. 33 (Blk. Twp.) 11 (Sur. Rge.) 19W Map No.

Operator Flourney Drlg.

Well No. 2 Farm Solomon

Elev. Location SW NE NW

	0				
FIRST REPORT					

990 Ft. From N Line NW

990 Ft. From E Line Quarter

Ist. Report JAN 14 1953

Completion _____

Remarks _____

Nye - Contr.

Spudding Date 1-11-53

Drlg. Data _____

8" @ 108

Kansas

Map No. _____ Sec. 33 Twp. 11 R. 19W

Well No. 3 Solomon

Flourney Drlg. Company

CORRECTION Contractor

SW NE NW

SECTION PLAT

990 Ft. from N. Line

_____ Ft. from S. Line

990 Ft. from E. Line

_____ Ft. from W. Line

	0		

Ellis County

Location _____

Rig up _____

Drilling and Remarks:

Reported
#2 Solomon

RECORD

Cased _____ in., _____ ft.

Sand _____

Gas _____

Oil _____

Total Depth _____

PRODUCTION

1st 24 hrs. Nat. _____

1st 24 hrs. after shot _____

Gas _____ Cu. Ft.

Dry Hole _____

Abandoned _____

Date

FEB 4 1953 19

J. G. MCGEHEE

Scout

County Ellis State Kansas

Sec. 33 (Blk. Twp.) 11 (Sur. Rge.) 19W Map No.

Operator Flourney Drlg.

Well No. 3 Farm Solomon

Elev. 2111 Location SW NE NW

	0				
COMPLETE					

990 Ft. From N Line NW

990 Ft. From E Line Quarter

Ist. Report

Completion FEB 1'8 1953

Remarks

Nye - Contr.

Spudding Date 1-11-53

Drlg. Data Oil well TD 3645

8" @ 108 Anhy 1426 -- Lans. 3343

Arb. 3638 TD 3645 4" @ 3643 CO to 3645

FU 1100' oil 12 hr. 250 A

Comp. 81 bopd

J. G. McGEHEE