


Section 33 Township 11 Range 19W

Well No. - 6 Solomon

Company Nye Drlg



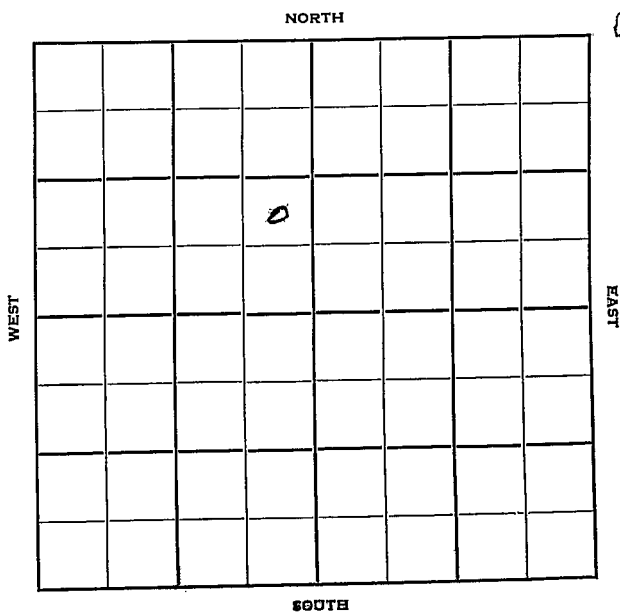

Sec. 33 Twp. 11 R. 19 W

Well No. # 6 Solomon Farm

Nye Drig. Company

Contractor


Ft. from N. Line

990 Ft. from S. Line

330 Ft. from E. Line

Ft. from W. Line

NE SE NW

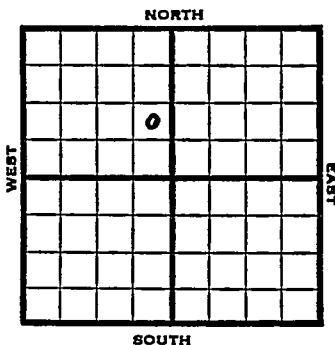

1952

Elev. 2117'

REPORT

12/30

Heeb 3312' Lans. 3353' Marm. 3580'
 Cong. 3603' Simp. 3624' Arb. 3642'
 TD 3645' 5" @ 3643' WOC

1/1

WOC on 5"

1/8

CO 3645 FU 400' oil 1/2 hr. s/5 BOPH
 5 Hrs.

1/22

NR

1/29

"

2/5

NR

2/11

Oil Well
 TD 3645
 Heeb 3312, Lans 3353, Marm
 3580, Cong 3603, Simp 3624, Arb
 3642,
 TD 3645
 5" @ 3643
 CO to 3645
 FU 400' oil 1/2 hrs.
 S/5 boph 5 hrs.
 Comp. 142 bopd

COMPLETED

County Ellis State Kansas

Sec. 33 (Blk. 11) (Sur. Rge.) 19W Map No.

Operator Nye Drig.

Well No. 6 Farm Solomon

Elev. 2117 Location NE SE NW

		0			
FIRST REPORT					

990 Ft. From S Line NW

330 Ft. From E Line Quarter

Ist. Report DEC 30 1957

Completion _____

Remarks _____

Spudding Date _____

Drig. Data _____

Heeh. 3312 Lans. 3353 Marm. 3580

Cong. 3603 Simp. 3624 Arb. 3642

TD 3645 5" @ 3643 WOC

County Ellis State Kansas

Sec. 33 (Blk. 11) (Sur. 19W) Map No.

Operator Nye Drlg.

Well No. 6 Farm Solomon

Elev. 2117 Location NE SE NW

		o			

990 Ft. From S Line NW

330 Ft. From E Line Quarter

1st. Report

Completion FEB 11 1953

Remarks

Spudding Date

Drlg. Data Oil well TD 3645

Heeb. 3312 Lans. 3353 Marm. 3580

Cong. 3603 Simp. 3624 Arb. 3642

TD 3645 5" @ 3643 CO to 3645

FU 400' oil 1/2 hr. S/ 5 boph 5 hr.

Comp. 142 bopd

J. G. McGEHEE