


Section 33 Township II Range 17W

Well No. #15 Bemis "A"

Company York State

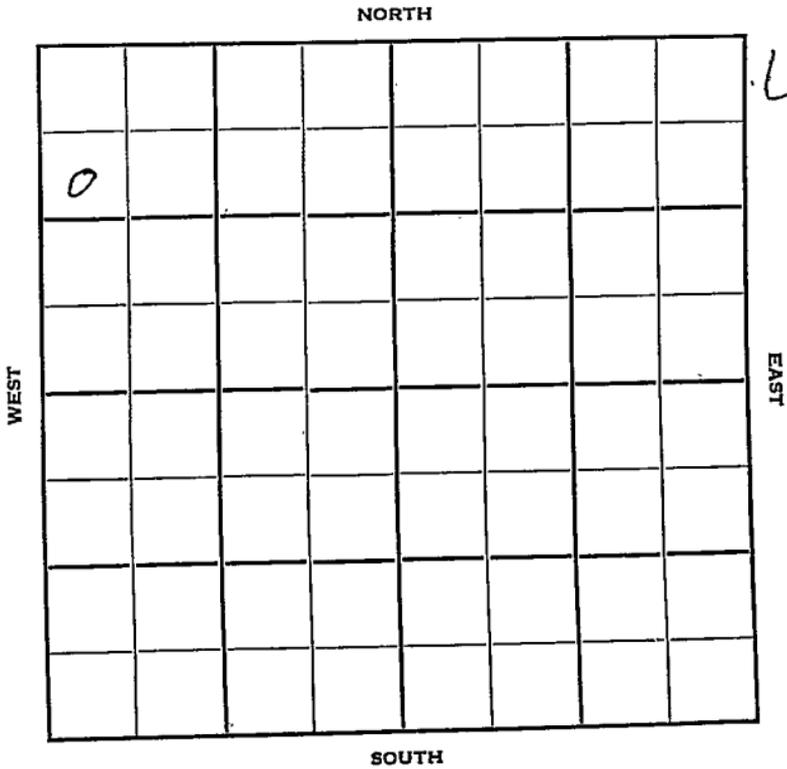

Ellis KANSAS

Sec. 33 Twp. 11 R. 17W ✓

Well No. #15 Bemis "A" Farm

York State

Company

Contractor

Bemis Pool


990' Ft. from N. Line

Ft. from S. Line

Ft. from E. Line

330' Ft. from W. Line

SW NW NW

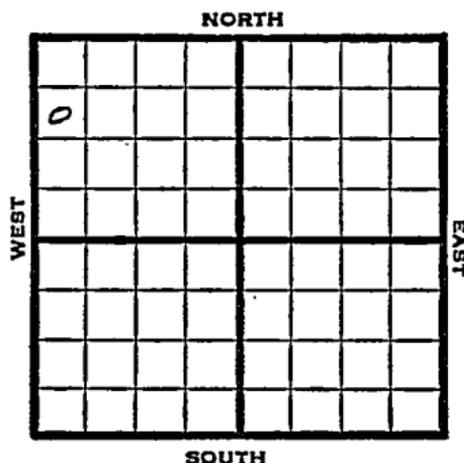

1950

Elev 1996' ¹⁹⁷⁶ REPORT

1/25

Location

3/29

TD 3540'
 8 5/8" @ 1255'
 5" @ 3481'
 Lans 3205'
 Simp 3461'
 Arv. 3482'
 D&A
 Aband.

ABANDONED

Kansas

Bemis Pool

Map No. _____ Sec. 33 Twp. 11 R. 17W

Well No. 15 Bemis "A"

York State

Company _____

Contractor _____

SW NW NW

SECTION PLAT

990 Ft. from N. Line

_____ Ft. from S. Line

_____ Ft. from E. Line

330 Ft. from W. Line



Ellis County

Location X

Rig up _____

Drilling and Remarks: _____

RECORD

Cased _____ in., _____ ft.

Sand _____

Gas _____

Oil _____

Total Depth _____

PRODUCTION

1st 24 hrs. Nat. _____

1st 24 hrs. after shot _____

Gas _____ Cu. Ft.

Dry Hole _____

Abandoned _____

Date

JAN 25 1950 19

J. E. TYRA

Scout

Kansas

Map No. _____ Sec. 33 Twp. 11 R. 17WWell No. 15 Bemis "A"

_____ York State _____ Company

_____ Contractor

SW NW NW

990 Ft. from N. Line

_____ Ft. from S. Line

_____ Ft. from E. Line

330 Ft. from W. Line

Ellis County

Location _____

Rig up _____

Drilling and Remarks:

8 5/8" @ 12555" @ 3481Lans 3205Simp 3461arb 3482D + A

RECORD

Cased _____ in., _____ ft.

Sand _____

Gas _____

Oil _____

Total Depth 3540

PRODUCTION

1st 24 hrs. Nat. _____

1st 24 hrs. after shot _____

Gas _____ Cu. Ft.

Dry Hole _____

Abandoned _____

Date

J. E. TYRA

MAR 29 1950 19 _____

Scout

El. 199
SECTION PLAT
1976