


Ellis

Section 33 Township 11 Range 17-III

Well No. #3 Bemis "B"

Company York state

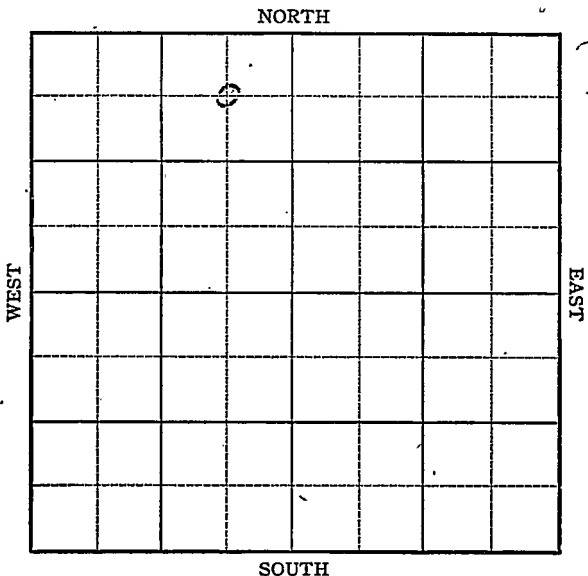

KANSAS

Ellis County

Sec. 33 Twp. 11 R. 17W

Well No. #3 Bemis "B" Farm _____
York State _____ Company _____

Bemis

330

_____ Ft. from N. Line


_____ Ft. from S. Line

330

_____ Ft. from E. Line

_____ Ft. from W. Line

NE NW

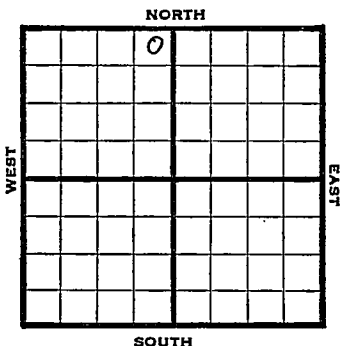

1946

2009

REPORT

8/14 Location

8/20 "

8/27 "

9/5 Drlg 540'

9/10 Anhy 1234'

8" @ 1240'

Drlg 2070'

9/18 Drlg 3450'

~~9/24 Drlg 3364'~~

9/24 Arb 3521

TD 3522'

5" @ 2521 RUST

10/1 TD 3531

500 acid

2000' oil in 24 hrs

10/8 " " "

10/15 " " "

10/22 " " "

10/30 Arb 3521'

5" @ 3521'

500 Acid

Pump 259 POT

TD 3531'

Grav. 33

COMPLETED

KANSAS

Kansas Pool Name Bemis

Map No. 71 Sec. 33 Twp. 11 R. 17W

Well No. 3 Bemis "B"

York State

Company

FIRST REPORT

Contractor

NE NW

SECTION PLAT

330 Ft. from N. Line

Ft. from S. Line

330 Ft. from E. Line

Ft. from W. Line

	2		

Ellis County

Location X

Rig up

Drilling and Remarks:

RECORD

Cased in. ft.

Sand

Gas

Oil

Total Depth

PRODUCTION

1st 24 hrs. Nat.

1st 24 hrs. after shot

Gas Cu. Ft.

Dry Hole

Abandoned

Date

AUG 14 1946

19

S. J. LEWIS

Scout

Kansas


Map No. 77 Sec. 33 Twp. 11 R. 17WWell No. 3 Bemis "B"York State

Company

COMPLETED

Contractor

NE NW

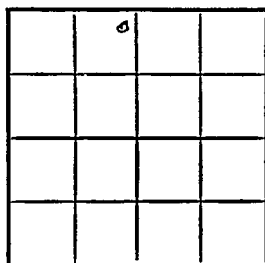E. 2009
SECTION PLAT330 Ft. from N. Line Ft. from S. Line330 Ft. from E. Line Ft. from W. LineEllis CountyLocation Rig up

Drilling and Remarks:

*Cut 3521**5" @ 3521**5000 cu ft**Pump 259 Bx**38° 54'***RECORD**Cased in., ft.Sand Gas Oil Total Depth *3531* **PRODUCTION**1st 24 hrs. Nat. 1st 24 hrs. after shot Gas Cu. Ft.Dry Hole Abandoned

Date

OCT 30 1946

19

S. J. LEWIS

Scout