


Section 33 Township 11 Range 17^W

Well No. #1 Bemis "B"

Company York State

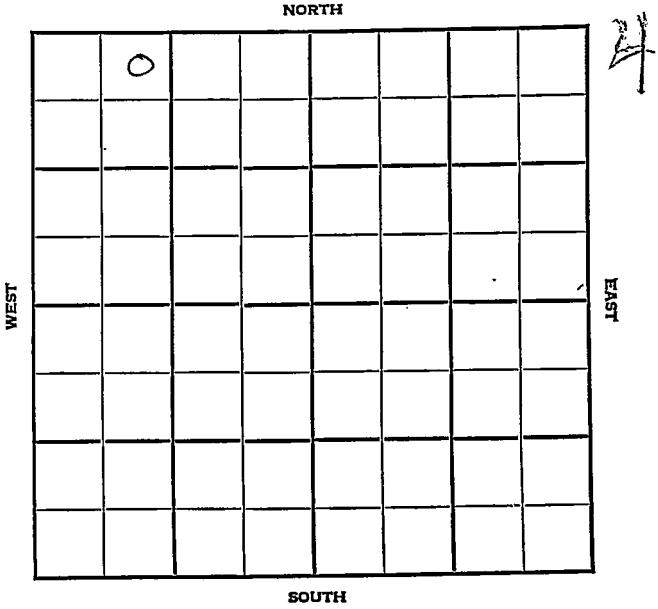

KANSAS

Ellis

Sec. 33 Twp. 11 R. 17W ✓

Well No. #4 Bemis "B" Farm

York State

Company

Bemis Pool


330' Ft. from N. Line

Ft. from S. Line

Ft. from E. Line

990' Ft. from W. Line

NE NW NW

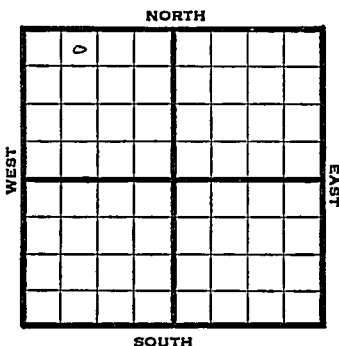

1948

Eli 1987'

REPORT

6/16	RUR
6/23	"
6/29	"
7/8	8" @ 1260' Drlg 2822'
7/14	Lansing 3229' Arb. 3485' TD 3490' Run 5"
7/21	5" @ 3487' RUST
7/28	500 acid
8/4	TD 3493' PB 3489½'
8/11	TD 3507' 500 acid swb 30 bbls oil 6 hrs.
8/18	TD 3516'
8/25	"
9/1	"
9/8	"
9/15	Arb. 3485' 5" @ 3487' TD 3516' 3000 acid P mp 126 oil / 4 W Pot 29° Gr. Comp

COMPLETED

Map No. _____ Sec. 33 Twp. 11 R. -17W

Well No. 4 Bemis "B"

York State Company

FIRST REPORT

Contractor

NE NW NW

330 Ft. from N. Line

_____ Ft. from S. Line

_____ Ft. from E. Line

990 Ft. from W. Line

SECTION PLAT

<u>0</u>			

Ellis County

Location _____

Rig up _____

Drilling and Remarks:

R U R

RECORD

Cased _____ ft.

Sand _____

Gas _____

Oil _____

Total Depth _____

PRODUCTION

1st 24 hrs. Nat. _____

1st 24 hrs. after shot _____

Gas _____ Cu. Ft.

Dry Hole _____

Abandoned _____

Date

JUN 1 6 1948

19

S. J. LEWIS

Scout

Ellis County Kansas State

Map No. 7 Sec. 33 Twp. 11 R. 17W

Well No. 4 Bemis "B"

York State Company

COMPLETE

Contractor

NE NW NW

E. 1987
SECTION PLAT

330 Ft. from N. Line

 Ft. from S. Line

 Ft. from E. Line

990 Ft. from W. Line

0							

Bemis Pool

Remarks:

CR 83483

5" 03487

8.178516

3000 acid

Pump 126 oil + 4 W 208

292 gr

Date
SEP 15 1948

Scout S. J. LEWIS