


KANSAS Ellis county

Section 33 Township 11 Range 17W

Well No. #2, Bemis "B" "D"

Company T.M. Deal O & G

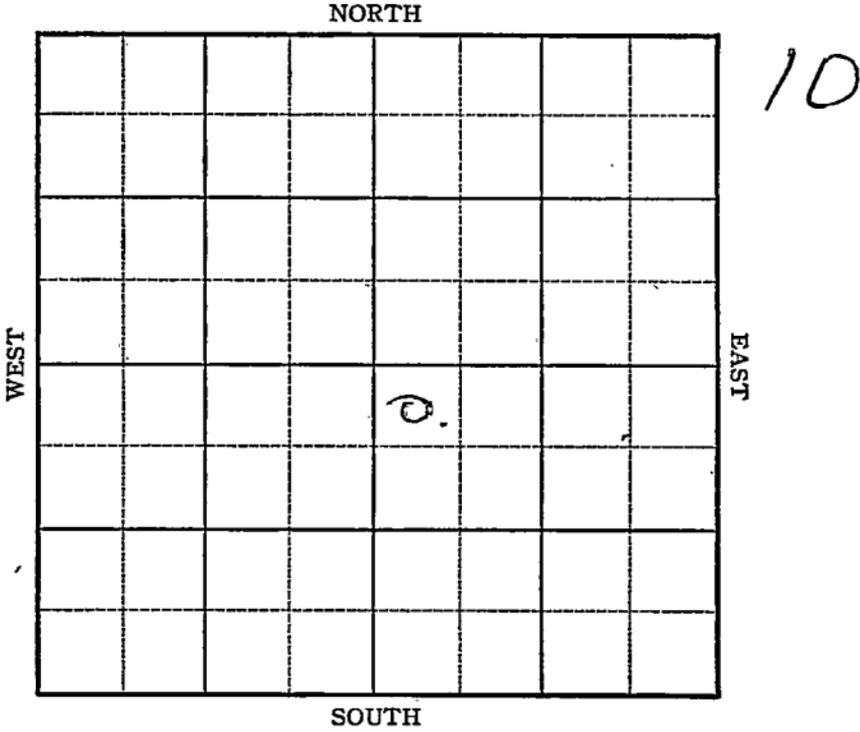

KANSAS

Ellis County

Sec. 33 Twp. 11 R. 17W

Well No. #2 Bemis "B" "D" Farm

T. M. Deal O & Gas Company

Bemis


400 Ft. from N. Line

_____ Ft. from S. Line

_____ Ft. from E. Line

330 Ft. from W. Line

NW SE

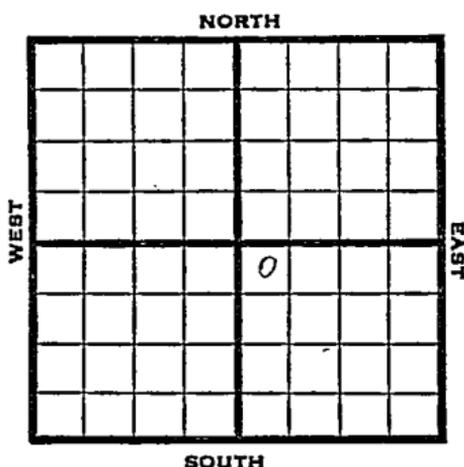

1946 Elev. 2026 REPORT

- 3/27 10" @ 1250
Lans 3252
3450'
- 4/4 No report
- 4/10 TD 3450
- 4/16 " "
- 4/23 TD 3580-VSSO
- 5/1 5" @ 3252
TD 3580-500 acid
- 5/7 TD3584-1800' oil
- 5/14 " " "
- 5/22 Lans 3252
TD 3584'
Pump 127 oil plus 2% W. Pot.
Grav. 34.0

COMPLETED

KANSAS Kansas Pool Name Bemis

Map No. 7 Sec. 33 Twp. 11 R. 17W

Well No. 2 Bemis "D"

T. M. Deal Oil & Gas Company

CORRECTION Contractor

NW SE

SECTION PLAT

400 Ft. from N. Line

_____ Ft. from S. Line

_____ Ft. from E. Line

330 Ft. from W. Line

		o	

Ellis County

Location _____

Rig up _____

Drilling and Remarks:

Reported

#2 Bemis "B"

RECORD

Cased _____ in., _____ ft.

Sand _____

Gas _____

Oil _____

Total Depth _____

PRODUCTION

1st 24 hrs. Nat. _____

1st 24 hrs. after shot _____

Gas _____ Cu. Ft.

Dry Hole _____

Abandoned _____

Date

APR 10 1946 19

S. J. LEWIS Scout

KANSAS

Kansas Pool Name Bemis

Map No. 77 Sec. 33 Twp. 11 R. 17W

Well No. 2 Bemis "B"

T. M. Deal O & Gas Company

FIRST REPORT

Contractor

NW SE


SECTION PLAT

400 Ft. from N. Line

_____ Ft. from S. Line

_____ Ft. from E. Line

330 Ft. from W. Line

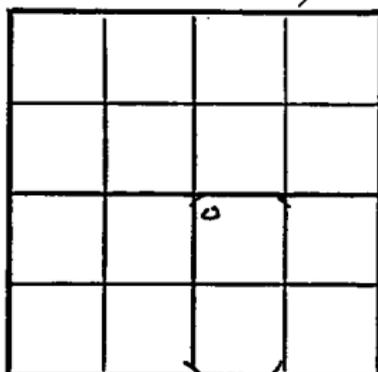

Ellis County

Location _____

Rig up _____

Drilling and Remarks:

10"-1250
Lans 3252
3450

RECORD

Cased _____ in., _____ ft.

Sand _____

Gas _____

Oil _____

Total Depth _____

PRODUCTION

1st 24 hrs. Nat. _____

1st 24 hrs. after shot _____

Gas _____ Cu. Ft.

Dry Hole _____

Abandoned _____

Date

27 1946

19

S. J. LEWIS

Scout

