


Section 33 Township 11 Range 17-W

Well No. #1 F. Bemis

Company Margay & Lario

NORTH Bemis Pool

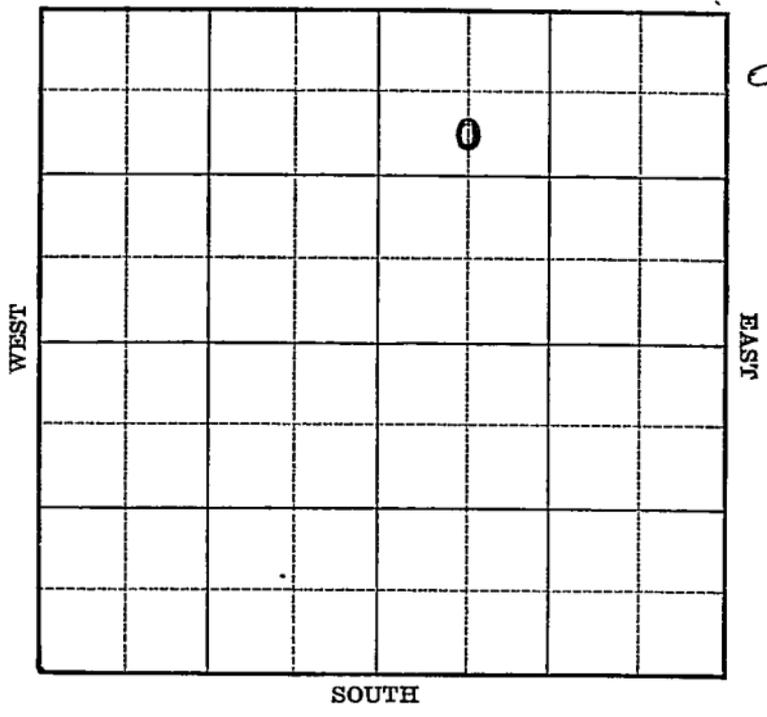

Sec. 33 Twp. 11 R. 17-W

Well No. #1 F. Bemis Farm

Margay & Lario Company

(Bemis)


990 Ft. from N. Line

_____ Ft. from S. Line

_____ Ft. from E. Line

660 Ft. from W. Line

Elev. 1965

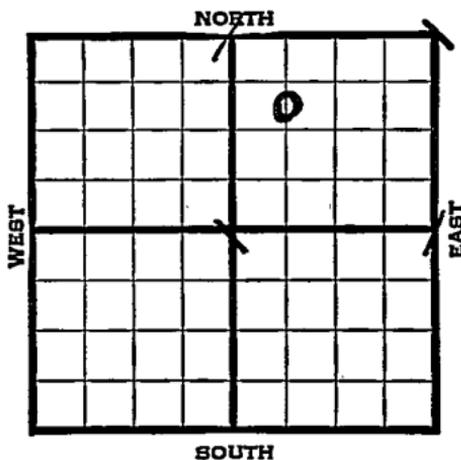

1939	REPORT
8/23	Material.
8/31	Anhy 1186' 8" - 1189' WOC.
9/7	Drlg. 3195'
9/14	Simp. 3457' Arb. 3472½' Sat.
	T.D. 3473½' 5" - 3473½' RUST.
9/20	Arb. 3472½'
	T.D. 3484'
	5" - 3473½'
	15 bbls. oil.
	COMPLETED

Map No. 71 Sec. 33 Twp. 11 R. 17W

Well No. 1 F Bemis

Margay & Laris Company

C S 1/2 NW NE Contractor

FIRST REPORT

990 Ft. from N. Line

_____ Ft. from S. Line

_____ Ft. from E. Line

660 Ft. from W. Line

SECTION PLAT

Bemis Pool

Location _____

Rig up _____

Drilling and Remarks:

Material

RECORD

Cased _____ in., _____ ft.

Sand _____

Gas _____

Oil _____

Total Depth _____

PRODUCTION

1st 24 hrs. Nat. _____

1st 24 hrs. after shot _____

Gas _____ Cu. Ft.

Dry Hole _____

Abandoned _____

Date

AUG 23 1939

19

S. J. LEWIS

Scout

Map No. 71 Sec. 33 Twp. 11 R. 17W

Well No. 1 F. Bemis

Margay & Lario Company

Contractor

COMPLETED

C S $\frac{1}{2}$ NW NE

990 Ft. from N. Line


_____ Ft. from S. Line

_____ Ft. from E. Line

660 Ft. from W. Line

BEMIS POOL

SECTION PLAT

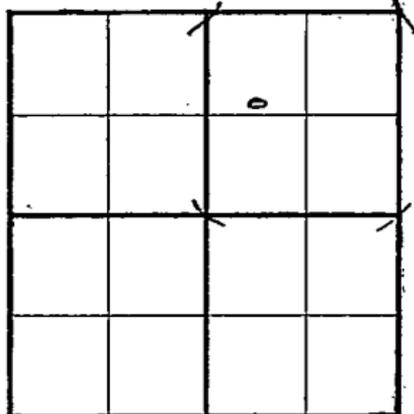

Location _____

Rig up _____

Drilling and Remarks:

Cu 83472 1/2
5 "C 3473 1/2
15 1/2

RECORD

Cased _____ in., _____ ft.

Sand _____

Gas _____

Oil _____

Total Depth 3484

PRODUCTION

1st 24 hrs. Nat. _____

1st 24 hrs. after shot _____

Gas _____ Cu. Ft.

Dry Hole _____

Abandoned _____

Date

SEP 20 1939 ₁₉

S. J. LEWIS Scout