


Section 33 Township 11 Range 17W

Well No. #3, Bemis "F"

Company Sohio & Lario

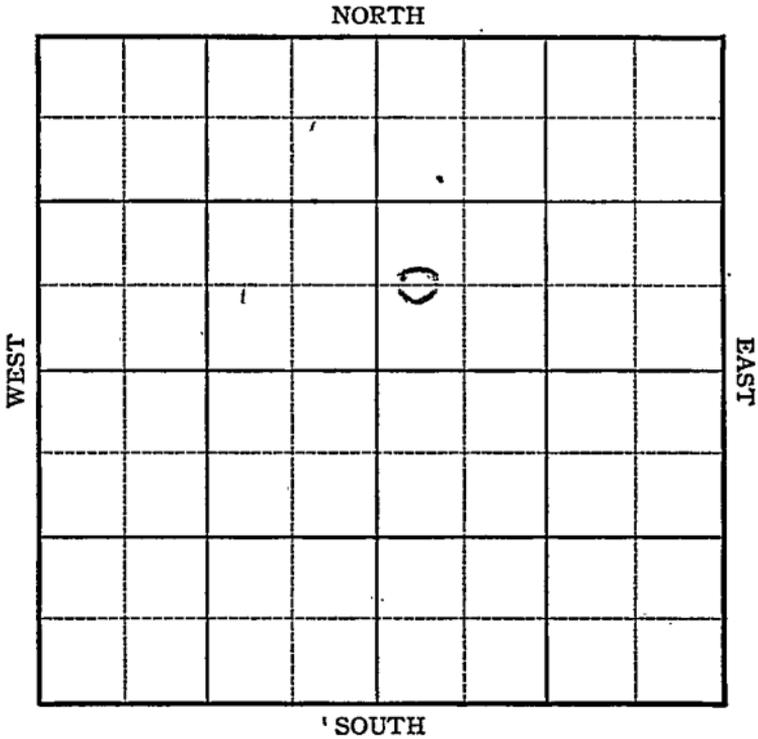

KANSAS

Ellis County

Sec. 33 Twp. 11 R. 17W

Well No. #3 Bemis "F" Farm

Sohio & Lario Company


Bemis

\_\_\_\_\_ Ft. from N. Line

660 \_\_\_\_\_ Ft. from S. Line

\_\_\_\_\_ Ft. from E. Line

330 \_\_\_\_\_ Ft. from W. Line

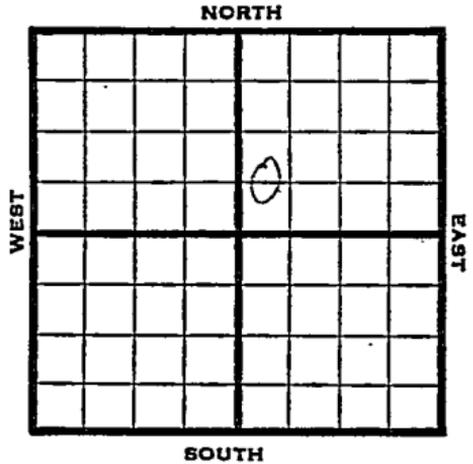

CWL SW NE

1946 Elev. 2014 REPORT

5/1 Anhy. 1237  
 5/7 8" @ 1246  
 Drlg 2465'  
 5/14 Arb 3532  
 TD 3534  
 5" @ 3532 RUST  
 5/21 TD 3537'  
 Swb 28 oil PH 8 hrs.  
 5/29 " " " "  
 6/5 Arb. 3532  
 5" @ 3532  
 TD 3537  
 Pump 584 Pot.  
 Grav. 34.0

COMPLETED

Pool Name Bemis  
 Kansas ~~Kansas~~  
 KANSAS  
 Map No. 7 Sec. 33 Twp. 11 R. 17W  
 Well No. 3 Bemis "F"  
 Sohio & Lario Company

## FIRST REPORT

Contractor

C W L S W N E

## SECTION PLAT

         Ft. from N. Line660 Ft. from S. Line         Ft. from E. Line330 Ft. from W. Line

		o	

Ellis County

Location         Rig up         

Drilling and Remarks:

Anhy. 1237

## RECORD

Cased          in.,          ft.Sand         Gas         Oil         Total Depth         

## PRODUCTION

1st 24 hrs. Nat.         1st 24 hrs. after shot         Gas          Cu. Ft.Dry Hole         Abandoned         

Date

MAY 1 1946 19

S. J. LEWIS Scout

