

Section 33 Township 11 Range 23WWell No. #1 HixsonCompany Davis Bros.

NORTH

							0

SOUTH

WEST

EAST

16


Sec. 33 Twp. 11S R. 23WWell No. #1 Hixson FarmMessrs. Elliott Davis & Leon Davis CompanyMurfin Drlg.

Contractor

MCPC donating \$3200.00 bottom hole money

 Ft. from N. Line330 Ft. from S. Line330 Ft. from E. Line Ft. from W. Line

SE SE SE

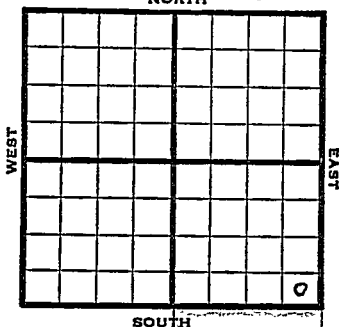

1951	Elev. 2410'	REPORT
9/4	4300' Arbuckle lime test	
10/3	To start by Dec. 1, 1951 To comp. by Feb. 1, 1952	
11/2	Location 8-5/8" @ 125. Drlg at 2855' (Ltr)	
11/9	Drilling at 4105' in Marmaton chert. Topeka 3484' Heebner 3680' Lansing 3723' B KC 3958'. (Ltr)	
11/16	Simp. 4194' Arb. 4211' TD 4233' D & A "	
11/14	Spud 10-29-51 D & A TD 4233' 8-5/8" @ 125 Top. 3484' Heeb 3680' Lans. 3723' B KC 3958' Simp. 4194' Arb. 4211' TD 4233' D & A	

ABANDONED

County **Trego** State **Kansas**

Sec. **33** (Blk. **11** (Sur. **2 3W** Map No.

Operator **Davis Bros.**

Well No. 1 Farm Hixson

Elev.	Location	SE SE SE
-------	----------	----------

[illegible]

330 Ft. From S Line SE

330 Ft. From R Line Quarter

1st. Report **OCT 3 1951**

Completion

Remarks	MCPC has NE of 4-12-23W- \$3200 BHM
---------	--

Spudding Date _____

Drlg. Data Wildcat

Location


J. E. TYRA

County Trego State Kansas
 Sec. 33 (Blk. Twp.) 11 (Sur. Rge.) 23W Map No.

Operator Davis Bros.

Well No. 1 Farm Hixson

Elev. 2410 Location SE SE SE

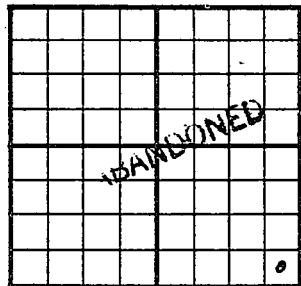

330 Ft. From S Line SE

330 Ft. From E Line Quarter

Ist. Report

Completion NOV 14 1951

Remarks Wildcat

Murfin Drlg. - Contr.

Spudding Date 10-29-51

Drlg. Data D & A TD 4233

8 5/8" @ 125 Top. 3484 Heeb. 3680

Lans. 3723 B KC 3958 Simp. 4194

Arb. 4211 TD 4233

D & A

J. E. TYRA