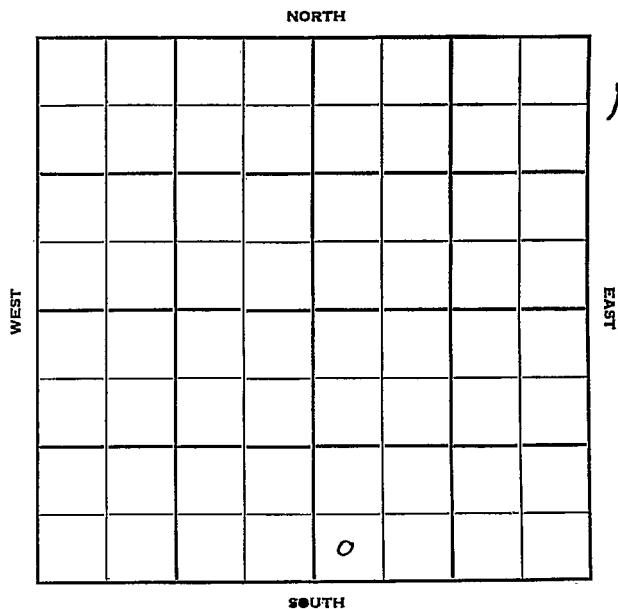


Section 33 Township 11 Range 25WWell No. #1 WeisbeckCompany Armer- et al

Trego KANSAS

Sec. 33 Twp. II R. 25 W

Well No. # 1 Weisbeck Farm

Armer - et al Company

Transit Contractor
Wildcat


Ft. from N. Line

330 Ft. from S. Line

Ft. from E. Line

330 Ft. from W. Line

SW SW SE
Phillips DHM

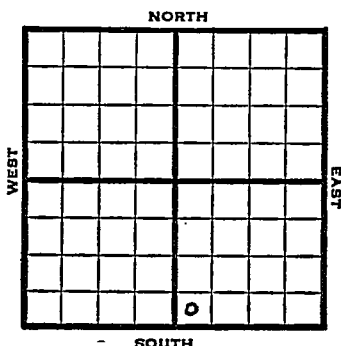


1952 Elev. 2577' REPORT

1/9 Spud 1-3-52
8" @ 240'
1/23 Drlg. 2951'
Spud 1-3-52
D & A TD 4725' 8" @ 350'
Heeb 3866' Lans. 3903'
DST 4076-4100 open 1 hr. rec 30' OCM
DST 4377-85 open 1 hr. rec 15' mud
Miss 4483' Viola 4630' Simp. 4673'
Arb. 4686'
TD 4725' D & A

ABANDONED

J. E. TYRA

County Trego State Kansas
 Sec. 33 (Blk. 11) (Sur. 25W) (Twp.) (Rge.) Map No.
 Operator Armer etal.
 Well No. 1 Farm Weisbeck
 Elev. 2577 Location SW SW SE

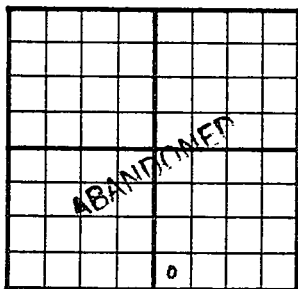

330 Ft. From S Line SE
330 Ft. From W Line Quarter
 1st. Report
 Completion JAN 23 1952
 Remarks Wildcat
Transit Drlg. - Contr.
 Spudding Date 1-3-52

Drlg. Data D & A TD 4725

8" @ 240 Heeb. 3866 Lans. 3903

DST 4076-4100 open 1 hr. Rec. 30' ocm

DST 4377-85 open 1 hr. Rec. 15' mud

Miss. 4483 Viola 4630 Simp. 4673

Arb. 4686 TD 4725

D & A

J. G. McGEHEE