


Russell

Section 34 Township II Range 15W

Well No. #1 Eulert

Company Carter Oil

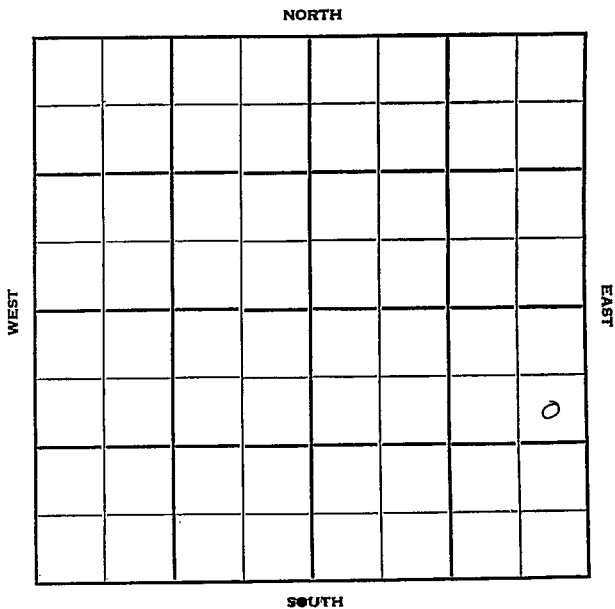

Russell

KANSAS

Sec. 34 Twp. 11 R. 15W ✓

Well No. #1 Eulert Farm

Carter Oil Company

Ferrell Drlg. - Cntr. Contractor

Eulert Pool


990' Ft. from N. Line

_____ Ft. from S. Line

330' Ft. from E. Line

_____ Ft. from W. Line

SE NE SE

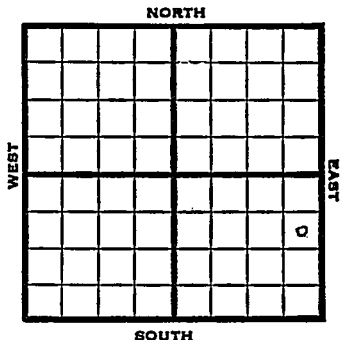

1950 Elv. 1776' REPORT

12/20 Spud 12-19-50

1951

1/10

Spud 12-19-50

D&A TD 3310

8-5/8" @ 173' Top 2632

Heeb. 2885 Dodge 2907

Lans. 2938

DST 2977-84 opn 2 hrs Rec. 100'

mud & sw Arb. 3264'

DST 3260-64 opn 1/2 hr Rec. 5' mud

DST 3264-72 opn 1/2 hr Rec. 10' mud

DST 3268-75 opn 1/2 hr. Rec. 30' mud

DST 3275-3310 opn 1/2 hr Rec. 180' sw

TD 3310 D&A

ABANDONED

