


Section 34 Township 11 Range 15W

Well No. #1 Enlert

Company Texas Company

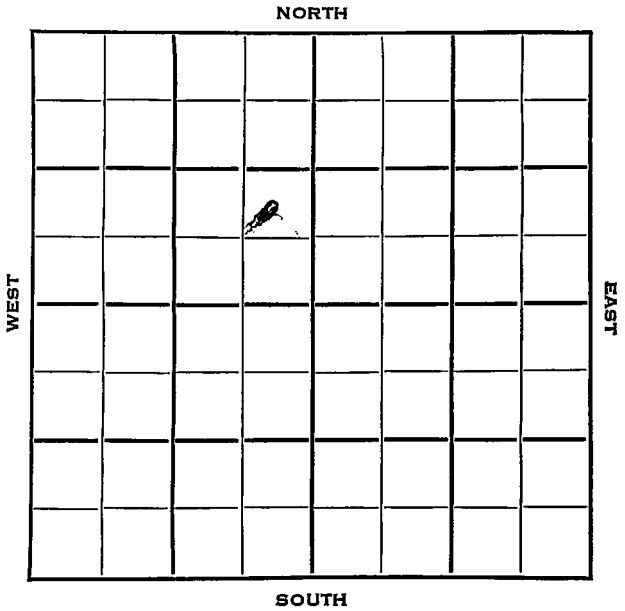

SEC.	TWP.	R.
34	11	15 W ✓

WELL NO. # 1 Eulert FARM

COMPANY Texas Company

CONTRACTOR Stickle Drlg.


W. Eulert Pool  
 \_\_\_\_\_ Ft. from N. Line

990 \_\_\_\_\_ Ft. from S. Line

330 \_\_\_\_\_ Ft. from E. Line

\_\_\_\_\_ Ft. from W. Line

NE SE NW

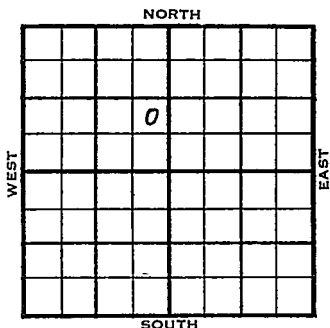

	ELEVATION	REPORT
1954	1756'	
3/17	Spud 3-16-54 Drlg. 190'	
3/24	10" @ 328 w/350 Top 2609' DST 2640-50, 1 hr, 10' M 950# Drlg. 2775'	
4/21	Spud 3-16-54 D&A TD 3251' 10" @ 328' Top 2609' DST 2640-50', opn 1 hr., rec. 10' mud, 950# DST 2811-35', opn 1 hr., rec. 45' mud, 850# Heeb 2857', Tor 2877' DST 2878-90', opn 1 hr., rec. 157' mud 30# Lans 2907' DST 2950-60', opn 2 hrs., rec. 120' gas, 160' mud, 60' SW, 495# DST 2993-3020', opn 1 hr., rec. 800' gas, 40' ocm, 150' sw, 390' mco, 620# DST 3092-3105', opn 2 hrs., rec. 15' ocm, 15# Arb. 3241' DST 3245-51', opn 1 hr., rec. 45' SW, 470#	

(Information Brought Forward)

1954  
4/21

TD 3251'  
7" @ 3050'  
CO to 3016  
19/3007-13, 3 go 15 gwph 5 hrs. 500A  
S/3 bo 11 bwph 13 hrs.  
CO to 3002', 13/2996-3000', S/6 gwph  
SSO, 500A  
S/1/2 bo 4 1/2 bwph 11 hrs.  
CO to 3016  
19/3006-12, S/2 bo 2 bwph 250A  
S/1 1/2 bo 6 bwph 10 hrs.  
ec. to 1/2 bo 5 bwph  
PB 2965'  
19/2950-56 16 gwph 5 hrs., 500A  
1 1/4 BO 4 1/4 BWPB 5 hrs.  
PB X 2661'  
17/2643-49, 67 gw 1 goph 8 hrs.  
D&A

ABANDONED

County **Russell** State **Kansas**

Sec. **34** (Blk. Twp.) **11** (Sur. Rge.) **15W** Map No.

Operator **Texas Company**

Well No. **1** Farm **Eulert**

Elev. **1756** Location **NE SE NW**

	0		
<b>FIRST REPORT</b>			

**990** Ft. From **S** Line **NW**

**330** Ft. From **E** Line Quarter

1st. Report **MAR 17 1954**

Completion \_\_\_\_\_

Remarks \_\_\_\_\_

**Stickle Drlg. - Contr.**

Spudding Date **3-16-54**

Drlg. Data **W. Eulert Pool**

**drlg. 190**



Drig. Data

CO to 3002 ~~13/2096-3000~~ ~~8/16~~ gwph

SSO 500 A ~~S/1/2 bo 4 1/2~~ hr.

CO to 3016 ~~19/3006-12~~ 2 bwph

250 A S/ ~~1 1/2 bo 6~~ dec. to

~~1/2 bo 5 bwph~~ ~~PB 2985~~

16 gwph 5 hr. ~~500 A~~ ~~1 1/2 bo 4 1/2~~ bwph

5 hr. PB 2661 ~~17/2643-49~~ 67 gw

1 goph 8 hr.

APR 27 1954

D & A