


Section 34 Township 11 Range 15 W

Well No. # 20. C. Eulert

Company Carter Oil Co.

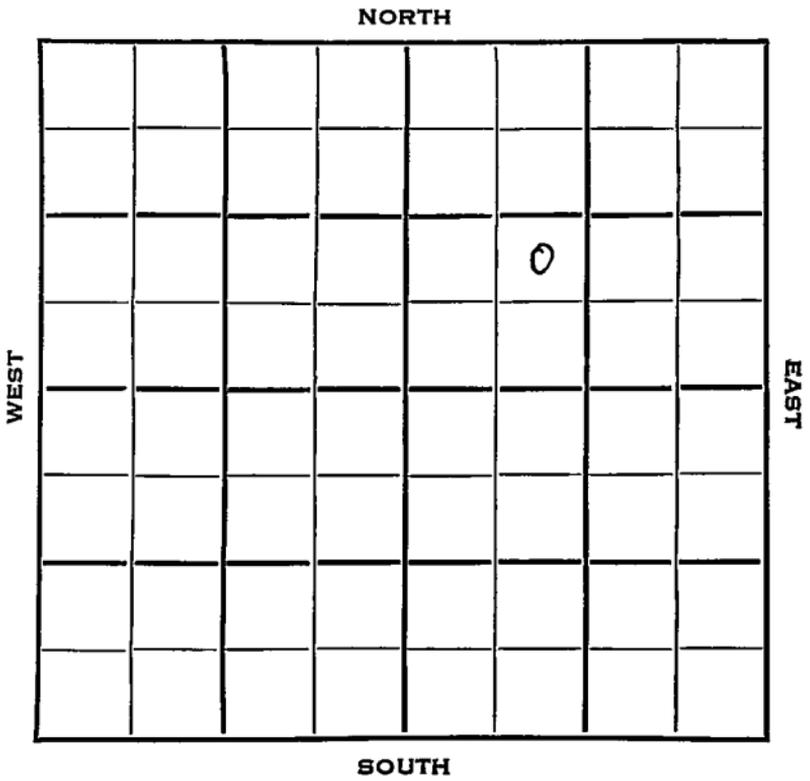

Russell KANSAS

SEC.	TWP.	R.
34	11	15W ✓

WELL NO. 2 O. C. Eulert FARM

COMPANY Carter Oil Co.

CONTRACTOR


Eulert Pool

_____ Ft. from N. Line

990 _____ Ft. from S. Line

_____ Ft. from E. Line

990 _____ Ft. from W. Line

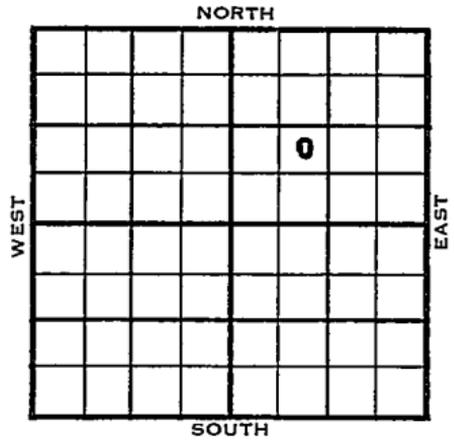

NE SW NE


1953	ELEVATION	REPORT
	1755'	

12/16 Location

1954
2/24

Spud 12-17-53
Oil Well
TD3247'
10" @ 197'
Top 2601', Heeb 2854', Dodge 2875',
Lans 2904'
DST 2943-56', opn 1½ hrs., rec. 10'
hocm, 230' gassy oil, 10' wtr, 590#
DST 3094-3105', opn 1 hr., rec. 8'
socm, 25#
Cong. 3214', arb. 3222'
DST 3223-26', opn 2 hrs., rec. 65'
vsocm,
TD 3226'
5" @ 3225',
GO to 3226', 2 go 1 gw
DD 3228', 3 go, DD 3231', 5½ go 50 A
S/1 bo, B/5 go 1 hr., 1500A, S/7 g bw
14 hrs., B/25 gw 1000A, DD 3244',
DD 3247', 5 go 1 gwph 18 hrs., 500A
PB 3108, 36/2948-54, B/12 gw 3 hrs.
1000A, S/114 bf 30% wtr. 2½ hrs.
S/18½ bo 5 bw 1 hr., S/13 bo 37 bw
11th hrs., S/151 bo 29½ bw 11 hrs.
Comp. 64 bopd 63 bw **COMPLETED**

County Russell State Kansas
 Sec. 34 (Blk.) 11 (Sur.) 15W Map No. (Twp.) (Rge.)
 Operator Carter Oil
 Well No. 2 Farm O. C. Eulert
 Elev. 1755 Location NE SW NE

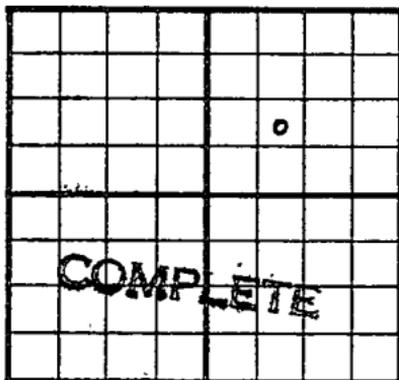

990 Ft. From S Line NE
990 Ft. From W Line Quarter
 1st. Report
 Completion FEB 24 1954
 Remarks Eulert Pool
Transit Drlg. - Contr.
 Spudding Date 12-17-53

Drlg. Data Oil well TD 3247

10" @ 197 Top. 2601 Heeb. 2854

Dodge 2875 Lans. 2904 DST 2943-56

open 1½ hr. Rec. 10' hocm 230' gassy oil

10' wtr. 590# DST 3094-3105

open 1 hr. Rec. 8' socm 25# Cong. 3214

Arb. 3222 DST 3223-26 open 2 hr.

Rec. 65' vsocm TD 3226 5" @ 3225

CO to 3226 2 go 1 gw DD 3228

3 go DD 3231 5½ go 50 A S/ 1 bo

B/ 5 go 1 hr. 1500 A S/ 7 bw 14 hr.

B/ 25 gw 1000 A DD 3244 DD 3247

5 go 1 gwph 18 hr. 500 A PB 3108

36/ 2948-54 B/ 12 gw 3 hr. 1000 A

S/ 114 bf 30% wtr. 2½ hr.

J. G. McGEHEE

