


Section 34 Township 11 Range 18-W

Well No. #1 Clemente

Company Lario Oil & Ref.
Wildcat

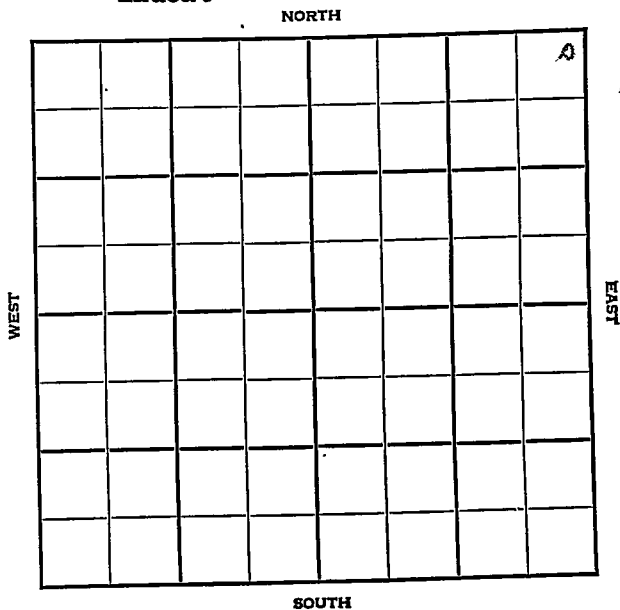

Sec. 34 Twp. 11 R. 18W

Well No. #1 Clements Farm


Lario Oil & Refg. Company

Wildcat

NORTH

330'

Ft. from N. Line

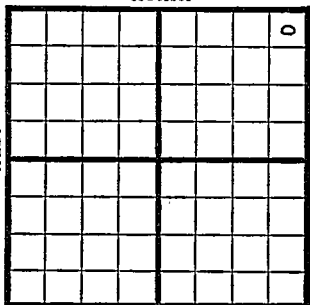

Ft. from S. Line

330'

Ft. from E. Line

Ft. from W. Line

NE/C

SOUTH

1948

Elev 2114'

REPORT

6/16

8" @ 1389'
Anhy. 1376'
Drlg. 2300'

6/23

TD 3726'
Lans. 3390'
Arb. 3711'
Aband.

ABANDONED

Map No. 71 Sec. 34 Twp. 11 R. 18W

Well No. 1 Clements

Larion Oil & Ref. Company

ABANDONED

Contractor

NE/c

E. 2117
SECTION PLAT

330 Ft. from N. Line

_____ Ft. from S. Line

330 Ft. from E. Line

_____ Ft. from W. Line

			0

Ellis County

Location _____

Rig up _____

Drilling and Remarks:

Loss 3390

CE 78711

RECORD

Cased _____ in., _____ ft.

Sand _____

Gas _____

Oil _____

Total Depth 3226

PRODUCTION

1st 24 hrs. Nat. _____

1st 24 hrs. after shot _____

Gas _____ Cu. Ft.

Dry Hole _____

Abandoned _____

Date

JUN 23 1948

S. J. LEWIS Scout

Map No. _____ Sec. 34 Twp. 11 R. 18W

Well No. 1 Clements

Lario Oil & Ref. Company

FIRST REPORT

Contractor

NE/C

SECTION PLAT

330 Ft. from N. Line

_____ Ft. from S. Line

330 Ft. from E. Line

_____ Ft. from W. Line

Ellis County

Location _____

Rig up _____

Drilling and Remarks:

8" @ 1389

Anhy 1376

drlg. 2300

RECORD

Cased _____ ft.

Sand _____

Gas _____

Oil _____

Total Depth _____

PRODUCTION

1st 24 hrs. Nat. _____

1st 24 hrs. after shot _____

Gas _____ Cu. Ft.

Dry Hole _____

Abandoned _____

Date

JUN 16 1948 19

S. J. LEWIS Scout