


Section 34 Township 11 Range 18-W

Well No. #1 Stecklein

Company G-M-R Oil

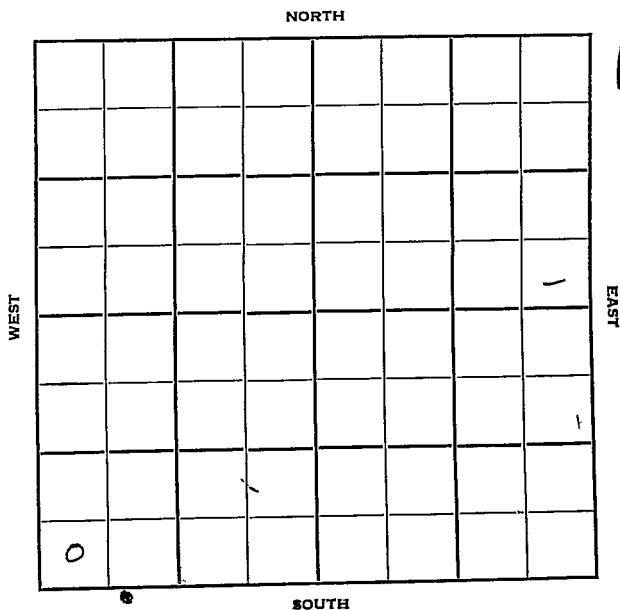

13

Ellis KANSAS

Sec. 34 Twp. 11 R. 18W ✓

Well No. #1 Stecklein Farm

G-M-R Oil Company

Wildcat Contractor

Ft. from N. Line

330'


Ft. from S. Line

Ft. from E. Line

330'

Ft. from W. Line

SW SW SW

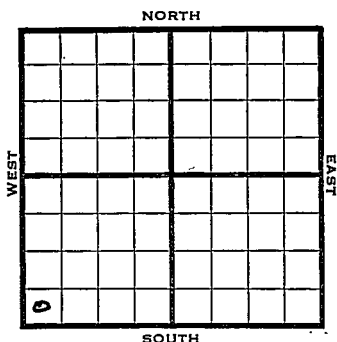

1950

Elev 2152

REPORT

8/9

Location

8/23

Spud 8-12-50

8" @ 216

Anhy 1450-87

Heeb 3372

Toronto 3392

Lans 3410

Cong 3716


Arb 3753

TD 3783

D&A

ABANDONED

J. E. TYRA

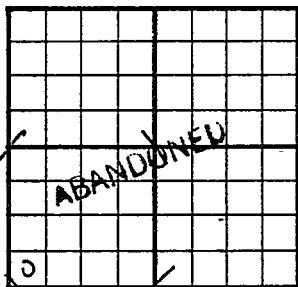County Ellis State KansasSec. 34 (Blk.
Twp.) 11 (Sur.
Rge.) 18W Map No.Operator G-M-R OilWell No. 1 Farm SteckleinElev. 2152 Location SW SW SW330 Ft. From S Line SW330 Ft. From W Line Quarter

1st. Report

Completion AUG 23 1950

Remarks

WildcatSpudding Date 8-12-50Drig. Data D & A TD 37838" @ 216 Anhy 1450-87 Heeb. 3372Toronto 3392 Lans. 3410 Cong. 3716Arb. 3753 TD 3783 D & A

J. E. TYRA