

KANSAS

FORM 51 25M 3-49 PETROL

Ellis

Section 34 Township 11 Range 18W

Well No. 1 Walter

Company Brunson Drlg.

Walter
NORTH

				0				
SOUTH								
WEST								EAST

15

KANSAS

Ellis

Sec. 34 Twp. 11 R. 18W ✓

Well No. #1 **Walter** Farm

Brunson Drlg. Company

Walter Pool


 Ft. from N. Line

330'

 Ft. from S. Line

 Ft. from E. Line

330' Ft. from W. Line

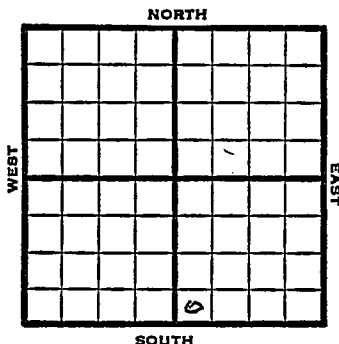

SW SE

1949

Elev 1846' REPORT

4/20

8" @ 191'

Anhy. 1400'

Drlg. 2005'

4/27

Lansing 3385'

Drlg 3545'

5/11

TD 3400'

Lans. 3017'

Arb. 3281'

5" @ 3346'

Perf Lans.

Pump 75 Oil Pot

27° Gr.

Comp

COMPLETED

Kansas

Walter Pool


Map No. _____ Sec. 34 Twp. 11 R. 18WWell No. 1 WalterBrunson D. lg. Company

FIRST REPORT

Contractor

SW SE

SECTION PLAT

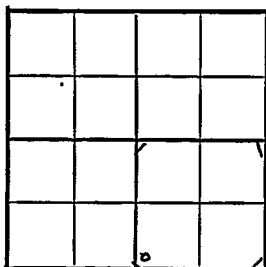

_____ Ft. from N. Line

330 Ft. from S. Line

_____ Ft. from E. Line

330 Ft. from W. LineEllis County

Location _____

Rig up _____

Drilling and Remarks:

8" @ 191'

Anhy 1400

drlg. 2005

RECORD

Cased _____ in., _____ ft.

Sand _____

Gas _____

Oil _____

Total Depth _____

PRODUCTION

1st 24 hrs. Nat. _____

1st 24 hrs. after shot _____

Gas _____ Cu. Ft.

Dry Hole _____

Abandoned _____

Date _____

APR 20 1949

19

S. J. LEWIS

Scout

1.

Scout Cards	
Land Small Map	
Land Wall Map	
Tracings	
France Map	
Pierce Map	
Misc.	

Map No. K 71 Sec. 34 Twp. 11 R. 18W

Well No. 1 Walter

Brunson Drlg. Company

COMPLETE Contractor

SW SE


E. 1846
SECTION PLAT

 Ft. from N. Line

330 Ft. from S. Line

 Ft. from E. Line

330 Ft. from W. Line

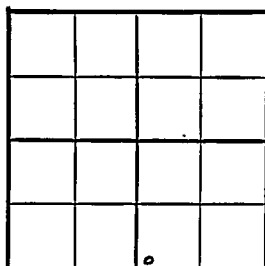

Ellis County

Location

Rig up

Drilling and Remarks:

Lane 3017

Art 3287

5" @ 3346

Perf Lane.

Prod 25 oil Per

27° 34'

RECORD

Cased in., ft.

Sand

Gas

Oil

Total Depth 3400

PRODUCTION

1st 24 hrs. Nat.

1st 24 hrs. after shot

Gas Cu. Ft.

Dry Hole

Abandoned

Date

MAY 4 1949 19

S. J. LEWIS

Scout

Sandy —

Check Spot —

~~Edith~~ ~~Edith~~

Eddie —

Scout Cards

Land Small Map

Land Wall Map

Tracings

France Map

Pierce Map

Misc.