


KANSAS

Ellis county

Section 34 Township 11 Range 17-W

Well No. #3, Dreiling

Company E. Wakefield

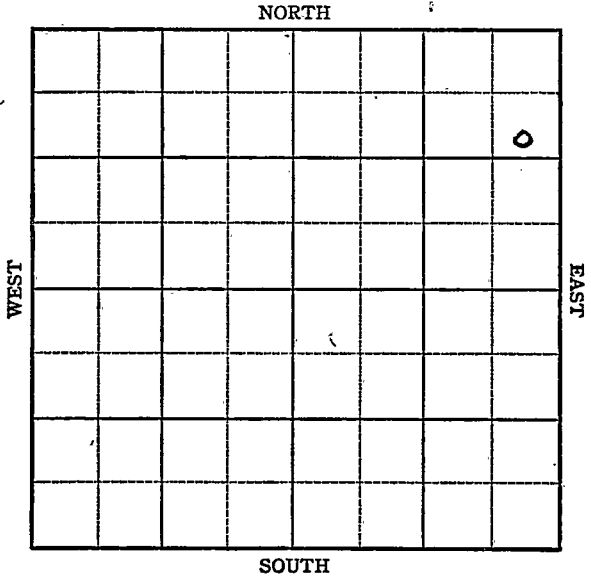

Ellis County ✓

Sec. 34 Twp. 11 R. 17W

Well No. 3 Drilling (TWIN) Farm
E. Wakefield Company


Bemis Pool

1020 Ft. from N. Line

Ft. from S. Line

330 Ft. from E. Line

Ft. from W. Line

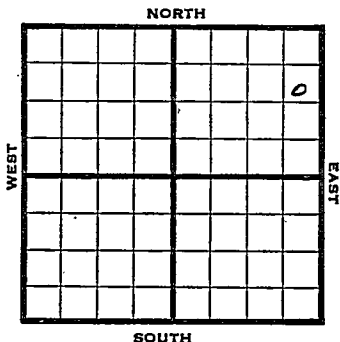

SE NE NE

1947	Elev. 1979	REPORT
1/8		Drilling 2700'
1/15		8" @ 890 Arb 3450 Drlg 3490'
1/21		" "
1/30		" "
2/5		TD 3494' Run 5"
2/19		" "
2/26		5" @ 3489' Corrected TD 3498' Swab 22 bbls oil PH 4 hrs
3/4		TD " "
3/11		TD 3498'
3/19		Arb 3450 5" @ 3489 Pump 25 Pot Grav. 33 TD 3498'

COMPLETED
OVER

Map No. 71 Sec. 34 Twp. 11 R. 17W

Well No. 3 Dreiling

E. Wakefield

Company

FIRST REPORT

Contractor

SE NE NE

SECTION PLAT

1020 Ft. from N. Line

_____ Ft. from S. Line

330 Ft. from E. Line

_____ Ft. from W. Line

			o

Ellis County

Location _____

Rig up _____

Drilling and Remarks:

twin well

2700'

RECORD

Cased _____ in., _____ ft.

Sand _____

Gas _____

Oil _____

Total Depth _____

PRODUCTION

1st 24 hrs. Nat. _____

1st 24 hrs. after shot _____

Gas _____ Cu. Ft.

Dry Hole _____

Abandoned _____

Date

JAN 8 1947 19

S. I. LEWIS Scout

KANSAS

Map No. 71 Sec. 34 Twp. 11 R. 17W

Well No. 3 Dreiling

E. Wakefield Company

COMPLETE Contractor

SE NE NE

E. 1979
SECTION PLAT

1020 Ft. from N. Line

_____ Ft. from S. Line

330 Ft. from E. Line

_____ Ft. from W. Line

			o

Ellis County

Location _____

Rig up _____

Drilling and Remarks:

CR 3450
5 103487
Pony 25 PD

CR 3450

RECORD

Cased _____ in., _____ ft.

Sand _____

Gas _____

Oil _____

Total Depth 3498

PRODUCTION

1st 24 hrs. Nat. _____

1st 24 hrs. after shot _____

Gas _____ Cu. Ft.

Dry Hole _____

Abandoned _____

Date

MAR 19 1947

S. J. LEWIS

Scout