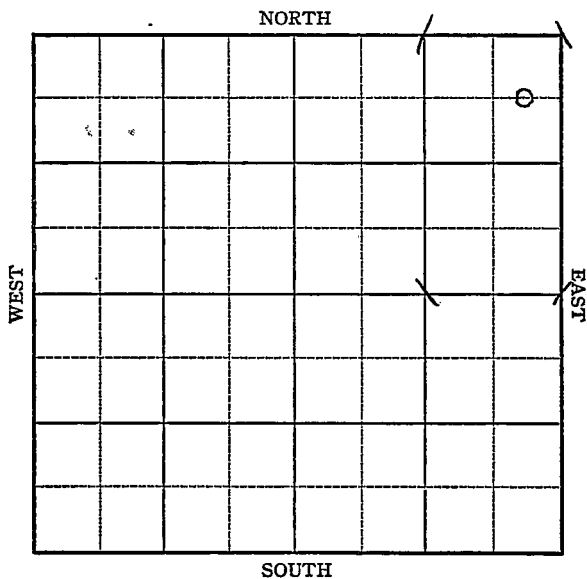


Section 34 Township 11 Range 17-WWell No. #1 DreilingCompany Earl Wakefield

KANSAS

Ellis

Sec. 34 Twp. 11 R. 17-W

Well No. #1 Dreiling Farm

Earl Wakefield Company


Benis

660 Ft. from N. Line

 Ft. from S. Line

330 Ft. from E. Line

 Ft. from W. Line

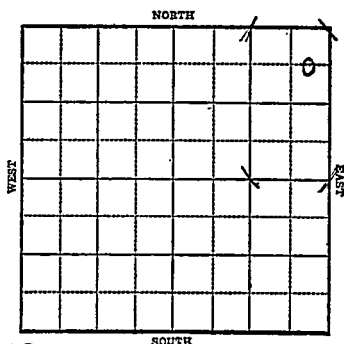

C EL NE NE *El. 1979*

1943

R E P O R T

2/17 198' -8"
Arb. 3454'
TD 3455'
5" Casing set 3455' RUST.

2/24 TD 3484-1600oil

3/3 " " " "

3/10 SD

3/16 "

3/24 " " " "

3/31 SD

4/7 "

4/14 500 acid Temp Pot 68'

4/21 Arb. 3454
5" @ 3455'
T.D. 3488'
500 gal. acid.
Pump 137 Pot.
Gravity 34

COMPLETED

Ellis

KANSAS

Map No. 77 Sec. 34 Twp. 11 R. 17WWell No. 1 Dreiling

Earl Wakefield

Company

FIRST REPORT

Contractor

C EL NE NE


660 Ft. from N. Line

Ft. from S. Line

330 Ft. from E. Line

Ft. from W. Line

SECTION PLAT

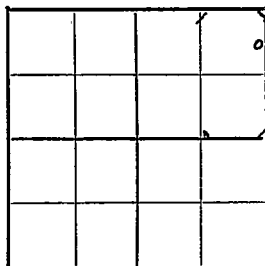

BEMIS POOL

Location

Rig up

Drilling and Remarks:

198' - 8"

Arb. 3454'

T.D. 3455'

5" - 3455'

R U S T

RECORD

Cased _____ in., _____ ft.

Sand _____

Gas _____

Oil _____

Total Depth _____

PRODUCTION

1st 24 hrs. Nat. _____

1st 24 hrs. after shot _____

Gas _____ Cu. Ft.

Dry Hole _____

Abandoned _____

Date

FEB 17 1943 19

S. J. LEWIS Scout

Ellis

KANSAS
 Map No. 18 Sec. 34 Twp. 11 R. 17W

Well No. 1 Dreiling

Earl Wakefield Company

COMPLETED Contractor

C E L N E N E


SECTION PLAT

660 Ft. from N. Line

 Ft. from S. Line

330 Ft. from E. Line

 Ft. from W. Line

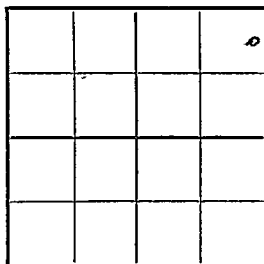

BEMIS POOL

Location Rig up

Drilling and Remarks:

*Cr 13454**5' 10" 13455**500 acid**Pump 137 Pst**342 Gr*

RECORD

Cased in., ft.Sand Gas Oil Total Depth 2488

PRODUCTION

1st 24 hrs. Nat. 1st 24 hrs. after shot. Gas Cu. Ft.Dry Hole Abandoned

Date

APR 21 1943

19

S. J. LEWIS Scout