FORM 51 25M 8-50 WESTERN


Ellis

KANSAS

Section 34 Township 11 Range 17 W

Well No. # 5 Drieling

Company E. F. Wakefield

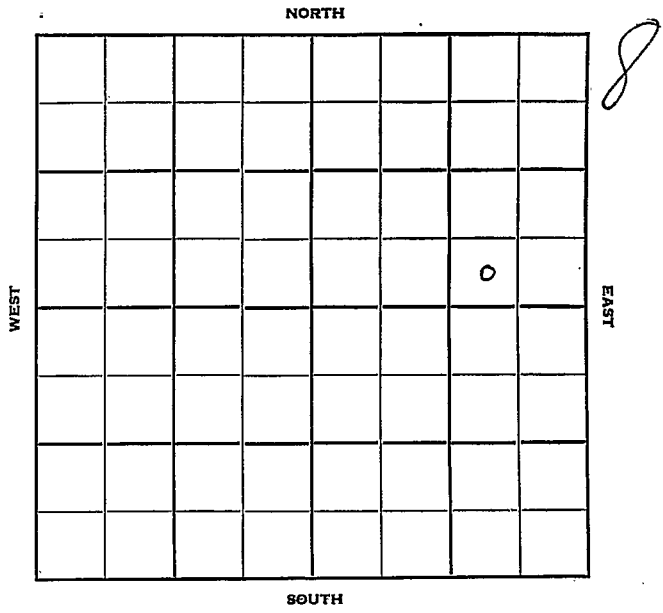

8

FORM 252-B
10M 11-50 PETROL

Ellis KANSAS

Sec. 34 Twp. 11 R. 17W

Well No. #5 Drieling Farm

E. F. Wakefield Company

Contractor

Bemis Pool


Ft. from N. Line

330' Ft. from S. Line

990' Ft. from E. Line

Ft. from W. Line

SW SE NE

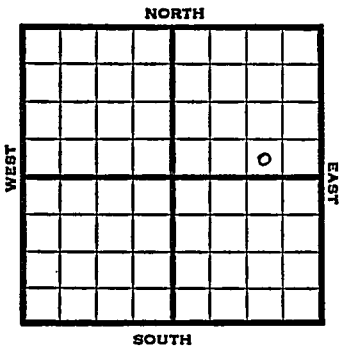

1951	Elev. 1994' REPORT
9/26	Location
11/7	Spud 10-9-51 Oil Well TD 3511 8" @ 128 Anhy 1125 KC 3213 Arb. 3469 TD 3511 5" @ 3505 500 A S/ 26 BOPH Comp. 150 BOPD

COMPLETED

FORM 275 FOR SALE BY KANSAS BLUE PRINT CO.


County Ellis State Kansas

Sec. 34 (Blk. Twp.) 11 (Sur. Rge.) 17W Map No.

Operator E. F. Wakefield

Well No. 5 Farm Drieling

Elev. Location SW SE NE

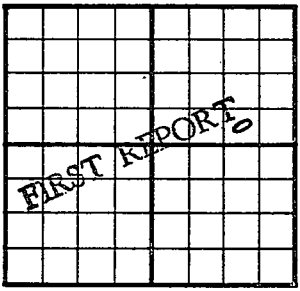

330 Ft. From S Line NE

990 Ft. From E Line Quarter

1st. Report SEP 26 1951

Completion

Remarks

Spudding Date

Drlg. Data Bemis - pool

Location

J. E. TYRA

FORM 275 FOR SALE BY KANSAS BLUE PRINT CO.


County Ellis State Kansas

Sec. 34 (Blk. Twp.) 11 (Sur. Rge.) 17W Map No.

Operator E. F. Wakefield

Well No. 5 Farm Dreiling

Elev. 1994 Location SW SE NE

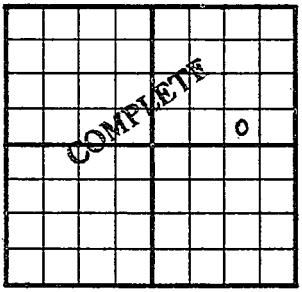

330 Ft. From S Line NE

990 Ft. From E Line Quarter

Ist. Report

Completion NOV 7 1951

Remarks Bemis Pool

Spudding Date 10-9-51

Drlg. Data Oil well TD 3511

8" @ 128 Anhy 1125 KC 3213 Arb. 3469

TD 3511 5" @ 3505 500 A S/ 26 boph

Comp. 150 bopd

J. E. TYRA