

KANSAS

Ellis

Sec. 34 Twp. 11 R. 17-W

Well No. #2 C. Dreiling Farm

Texas

Company

Bemis Pool


Ft. from N. Line

330' Ft. from S. Line

Ft. from E. Line

330' Ft. from W. Line

SW SE

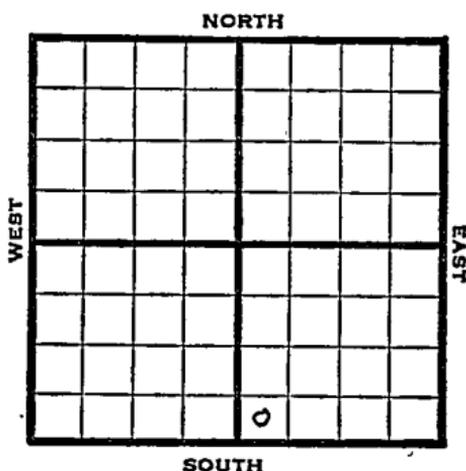

1947 Elev. 2083' REPORT

12/10 Loc.

12/17 "

12/30 8" @ 1289'
Drlg. 2580'

1948
1/7 Lansing 3319'
Arbuckle 3570-73' TD
5" @ 3568'
RUST

1/14 3579' 1000 acid
swb 2½ bbls oil PH 6 hrs
Drlg 3588'

1/21 TD 3588'
500 Acid
Pump 50 bbls oil 4 hrs.

1/26 30 qts. 3575-88'
Swb. ½ bbls oil PH

2/4 Arb. 3570'
5" @ 3568'
500 acid
Pump 137 oil pot
36.0 Gr.
TD 3588'
Comp.

COMPLETED

Map No. _____ Sec. 34 Twp. 11 R. 17W

Well No. 2 C. Dreiling

Texas

Company _____

FIRST REPORT

Contractor _____

SW SE

SECTION PLAT

_____ Ft. from N. Line

330 Ft. from S. Line

_____ Ft. from E. Line

330 Ft. from W. Line

Ellis County

Location X

Rig up _____

Drilling and Remarks:

RECORD

Cased _____ in., _____ ft.

Sand _____

Gas _____

Oil _____

Total Depth _____

PRODUCTION.

1st 24 hrs. Nat. _____

1st 24 hrs. after shot _____

Gas _____ Cu. Ft.

Dry Hole _____

Abandoned _____

Date

DEC 10 1947 19

S. J. LEWIS

Scout

Map No. 71 Sec. 34 Twp. 11 R. 17W

Well No. 2 C. Dreiling

Texas Company

COMPLETE

Contractor

SW SE

E. 2083

SECTION PLAT

_____ Ft. from N. Line

330 Ft. from S. Line

_____ Ft. from E. Line

330 Ft. from W. Line

Ellis County

Location _____

Rig up _____

Drilling and Remarks:

Art 3570
5" @ 3568
5000 oil
Pump 187 oil
86 2/3

RECORD

Cased _____ in., _____ ft.

Sand _____

Gas _____

Oil

Total Depth 2588

PRODUCTION

1st 24 hrs. Nat. _____

1st 24 hrs. after shot _____

Gas _____ Cu. Ft.

Dry Hole _____

Abandoned _____

Date

FEB 4 1948 19

S. J. LEWIS Scout