


Section 34 Township 11 Range 17-W

Well No. #2 Hauser

Company Cities Service Oil

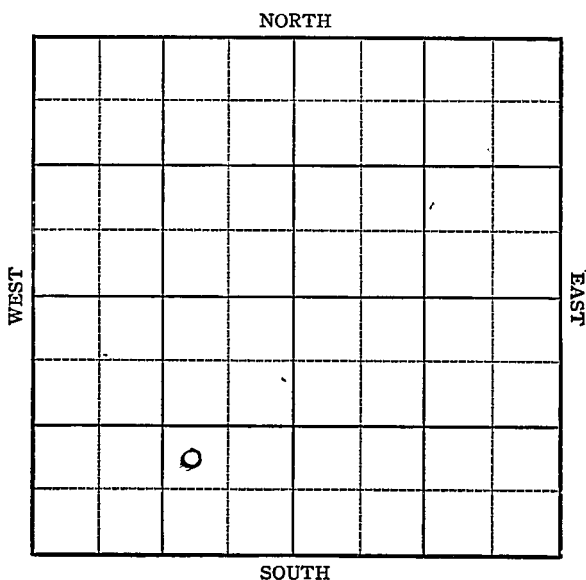

KANSAS


-Ellis

Sec. 34 Twp. 11 R. 17-W

Well No. #2 Hauser Farm

Cities Service Oil Company

NORTH

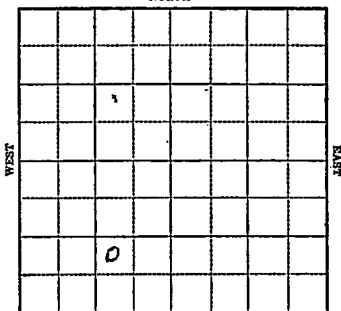

 Ft. from N. Line

990 Ft. from S. Line

990 Ft. from E. Line

 Ft. from W. Line

Elev. 2112

SOUTH

1943

R E P O R T

11/3

Location

11/10

8" @ 266'

WOC

11/17

Dr1g. 2060'

12-1

Arb 3672

TD 3702

ABANDONED

KANSAS
 Map No. 34 Sec. 34 Twp. 11 R. 17W

Well No. 2 Hauser

Cities Service Oil Company

FIRST REPORT

Contractor

NW SE SW


SECTION PLAT

990 Ft. from N. Line

990 Ft. from S. Line

990 Ft. from E. Line

990 Ft. from W. Line

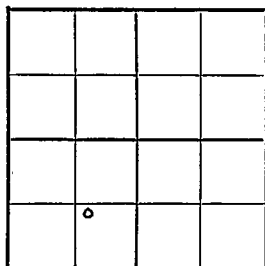

Bemis Pool

Location X

Rig up

Drilling and Remarks:

RECORD

Cased in. ft.

Sand

Gas

Oil

Total Depth

PRODUCTION

1st 24 hrs. Nat.

1st 24 hrs. after shot

Gas Cu. Ft.

Dry Hole

Abandoned

Date

NOV 3 1943 19 S. J. LEWIS Scout

Map No. KANSAS 7 Sec. 34 Twp. 11 R. 17W

Well No. ? Hauser

Cities Service Oil Company

ABANDONED Contractor

NW SE SW

SECTION PLAT

	o		

_____ Ft. from N. Line

990 Ft. from S. Line

990 Ft. from E. Line

_____ Ft. from W. Line

Bemis Pool

Location _____

Rig up _____

Drilling and Remarks:

Ar 83672

RECORD

Cased _____ in., _____ ft.

Sand _____

Gas _____

Oil _____

Total Depth 3202

PRODUCTION

1st 24 hrs. Nat. _____

1st 24 hrs. after shot _____

Gas _____ Cu. Ft.

Dry Hole _____

Abandoned _____

Date

DEC 1 1943 19

S. J. LEWIS Sc