


Section 34 Township 11 Range 17W

Well No. #4 Johansen

Company Texas Co.

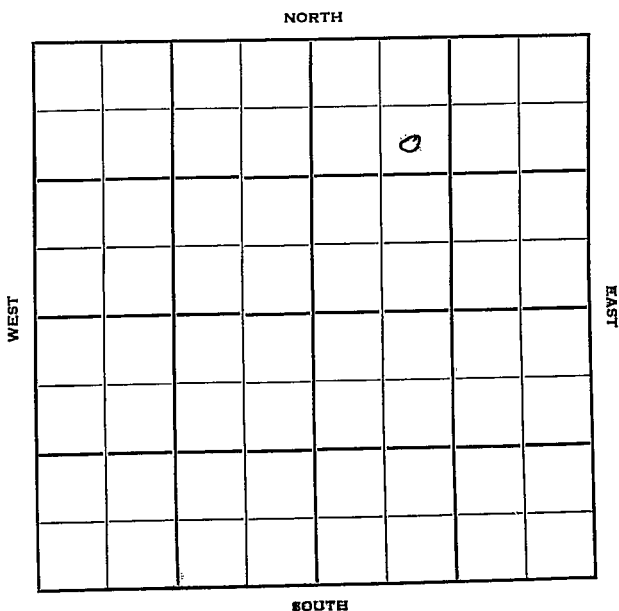

2

Ellis

KANSAS ✓

Sec. 34 Twp. 11 R. 17WWell No. #4 Johansen Farm

Texas Company

Company

Braden Drlg.

Contractor

990

Ft. from N. Line


Ft. from S. Line

Ft. from E. Line

990

Ft. from W. Line

SE NW NE

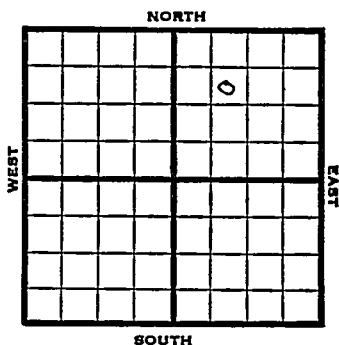

1952

Elev. 2100' REPORT

11/12 Spud 11-10-52
10" @ 248'

11/20 Drlg. 3050'

11/27 DST 3233-63, 1 hr., 10' M
Arb 3574
Drlg. 3606'

12/4 Topeka 3027 Heeb 3260 Tor 3281 Lans
3305 Arb 3571 TD 3622 7" @ 3622

12/11 C03619 37/3606-18 D-Hyd S/load
S/136 BO 14Hrs. P/10 BOPH

12/17 Spud 11-10-52
Oil Well
TD 3622
10" @ 248
DST 3233-63, opn 1 hr., rec.
10' mud
Top 3027, Heeb 3260, Tor 3281,
Lans. 3305', Arb. 3574,
TD 3622
7" @ 3622
C0 to 3619 37/3606-18 D-hydro
S/load S/136 bo 14 hrs.,
P/10 boph
Comp. 193 bopd 61 bw

COMPLETED


J. G. McGEHEE

County Ellis State Kansas
 Sec. 34 (Blk. Twp.) 11 (Sur. Rge.) 17W Map No.

Operator Texas Company

Well No. 4 Farm Johansen

Elev. 2100 Location SE NW NE

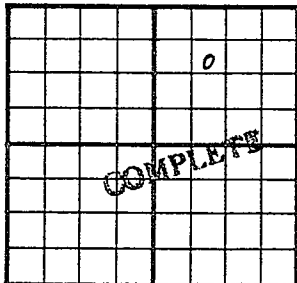

990 Ft. From N Line NE

990 Ft. From W Line Quarter

1st. Report

Completion DEC 17 1952

Remarks

Braden Drlg. - Contr.

Spudding Date 11-10-52

Drlg. Data Oil well TD 3622

10" @ 248 DST 3233-63 open 1 hr.

Rec. 10' mud Top. 3027 Heeb. 3260

Tor. 3281 Lans. 3305 Arb. 3574

TD 3622 7" @ 3622 CO to 3619

37/ 3606-18 D-hydro. S/ load

S/ 136 bo 14 hr. P/ 10 boph

Comp. 193 bopd .61 bw