


Ellis

KANSAS

SECTION 34 TOWNSHIP 11 RANGE 19 W

WELL NO. #1 Jensen

COMPANY Osage Oil

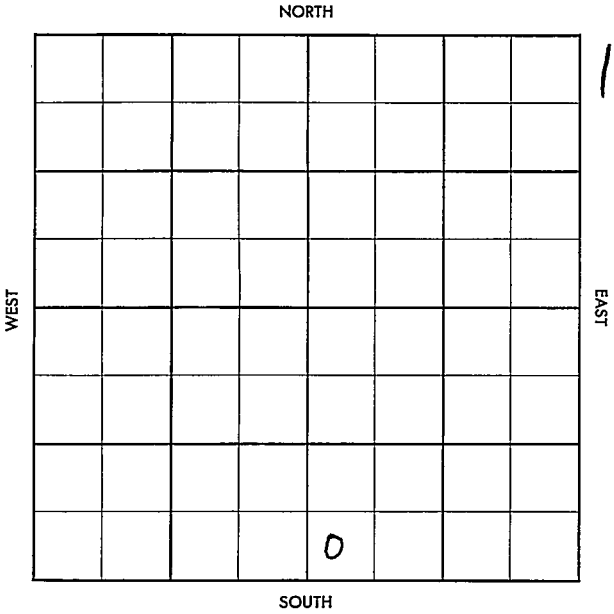

KANSAS

SEC.	TWP.	R.
34	11	19W
WELL NO.		
#1 Jensen		FARM
COMPANY		
Osage Oil		
CONTRACTOR		

WILDCAT


_Ft. from N. Line

Ft. from S. Line

Ft. from E. Line

Ft. from W. Line

SW SW SE

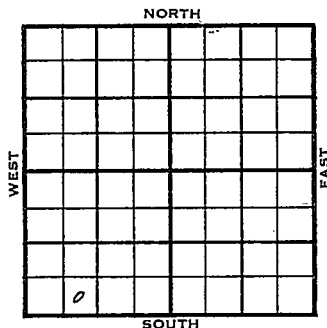

1955	ELEVATION 2131'	REPORT
11-30	Location	
12-14	Comm. 12-1-55 8 5/8" @ 224/140 DST 3150-64 op 1 1/2 hrs. rec. 115' wm 990/30" DST 3456-90 op 1 hr. rec. 45' drlg. mud 1110/20" D & A	
	<u>TOPS</u>	<u>DEPTH</u> <u>LOG</u>
	Anh.	1435
	Tp.	3120
	H.	3350
	Tr.	3370
	L.	3393
	BKC	3626
	C.	3660
	A.	3780
	TD 3795'	
		ABANDONED

DX-78

County











Farm Name

Jensen

No.

1

TOPS

DEPTH

LOG

DATUM

Loc. in Sec.

Anh.

Tp.

H.

Tr.

Dg.

BL.

L.

K.C.

B.K.C.

Ce.

C.

M.

M.

K.

Mz.

Ma.

V.

S.

S.

A.

R.

PE.

G.

G.

T.D.

SW SE

Geol.

Contr.

Pool

Wildcat

FIRST REPORT

NOV 30 '55

0

Date Comm.

Location

Co.

Lse.

No.


Sec.

T.

R.

County Ellis Elev. 2131
 Sec. 34 Twp. 71 Rge. 19W
 Company Osage Oil
 FarmName Jensen No. 1

TOPS	DEPTH	LOG	DATUM	Loc. in Sec.
Anh.	1435			SW SW SE
Ip.		3120	989	
H.	3350	3350	1219	
Tr.	3370	3370	1239	
Dg.				
Bl.				
L.	3393	3392	1261	Geol.
K.C.				
B.K.C.	3626		1495	Contr.
Ce.				
C.		3660	1529	Trans-Era
M.				
M.				Pool
K.				Wildcat
Mz.				
Me.				
V.				
S.				
S.				
A.	3780	3780	1649	
R.				
Pe.				
G.				
T.D.	3795			

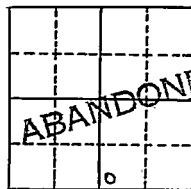

Date Comm. 12-1-55 DEC 1 4 1955
8 5/8" @ 224/140 DST 3150-64
open 1 1/2 hr. rec. 115' wmm 990/30"
DST 3456-90. open 1 hr. rec. 45' drlg.
mud 1110/20"

D & A.