



Sec. 34 Twp. 11 R. 19W

Well No. #1 Jensen Farm

Skelly Oil Company

Contractor

Wildcat


330 Ft. from N. Line

Ft. from S. Line

Ft. from E. Line

990 Ft. from W. Line

NE NW SW

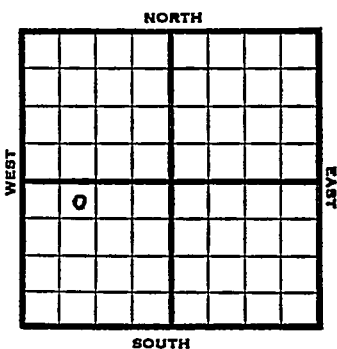

1953 Elev. 2121' REPORT

7/1 Location

7/22 Anhy 1408 8" @ 1418 w/500  
Drlg. 1800'

7/29 Top 3113, Heeb 3311, Tor 3330, Lans 3353, Cong 3620, Arb 3640-43, RTD 5" @ 3640'

8/5 NR

8/12 DD 3649' TD 5 GOPH 300 A  
P/55 BO 22 hrs. P/16 BO & 1 1/2 BW 6 hrs.

8/26 Spud 7-15-53 Oil well TD 3649  
Anhy 1408' 8" @ 1418 Top 3113  
Heeb 3311 Tor. 3330 Lans 3353  
Cong 3620 Arb. 3640 TD 3643  
5" @ 3640 DD 3649 5 GOPH 300 A  
P/55 BO 22 hr. P/16 BO 1 1/2 BW 6 hr.  
Simp. 3628 PB 3642 85/3632-41  
15 GOPH 2 hr. 500 A P/82 BO 4 BW  
10 hr. P/22 BO 5 hr. 800 A  
P/105 BO 3 BW 24 hrs. GO to 3649  
P/21 BO 2 hr. 3% wtr.  
Comp. 181 BOPD 1% wtr.

COMPLETED



