


Section 34 Township 11 Range 19W

Well No. #1 Jensen "B"

Company Skelly Oil

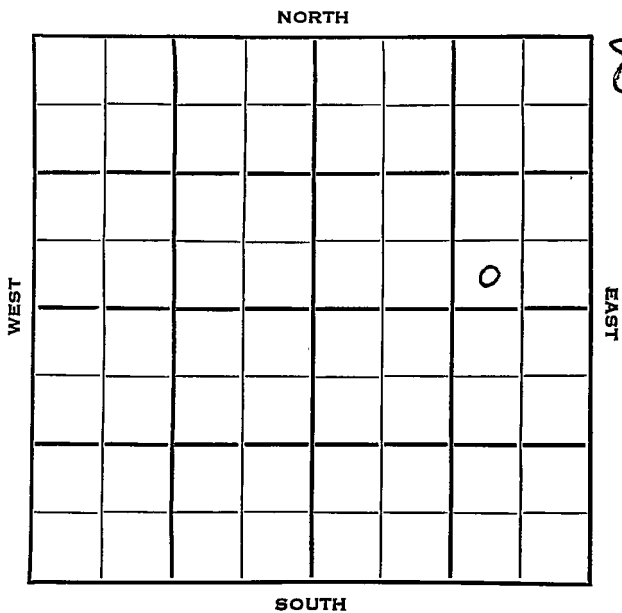

Sec. 34 Twp. 11 R. 19W

Well No. #1 Jensen "B" Farm

Skelly Oil Company

Contractor

Ft. from N. Line

330


Ft. from S. Line

990

Ft. from E. Line

Ft. from W. Line

SW SE NE

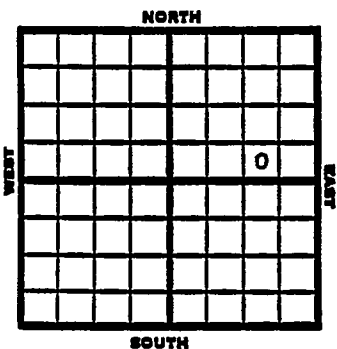

1953

Elev. 2135' REPORT

9/2

Location

9/9

"

9/16

Spud 9-1-53

D & A TD 3713' 8" @ 1450

Top 3143 Heeb 3341 Tor 3361

Lans 3386 Cong 3657 Arb. 3673

DST 3675-81 open $\frac{1}{2}$ hr rec 5' mud

DST 3676-94 open $\frac{1}{2}$ hr rec 5' mud 870#

DST 3678-3713 open 1 hr rec 135' SW

835# TD 3713' D & A

ABANDONED

County **Ellis** State **Kansas**

Sec. **34** (Blk. Twp.) **11** (Sur. Rge.) **19W** Map No.

Operator **Skelly Oil**

Well No. **1** Farm **Jensen "B"**

Elev. _____ Location **SW SE NE**

FIRST REPORT
0

330 Ft. From **S** Line **NE**

990 Ft. From **E** Line **Quarter**

1st. Report **SEP 2 1953**

Completion _____

Remarks _____

Spudding Date _____

Drlg. Data _____

Location

