


Ellis KANSAS

DX 78-1

Section 34 Township 11 Range 20W

Well No. 1 Homburg

Company Transit Corp

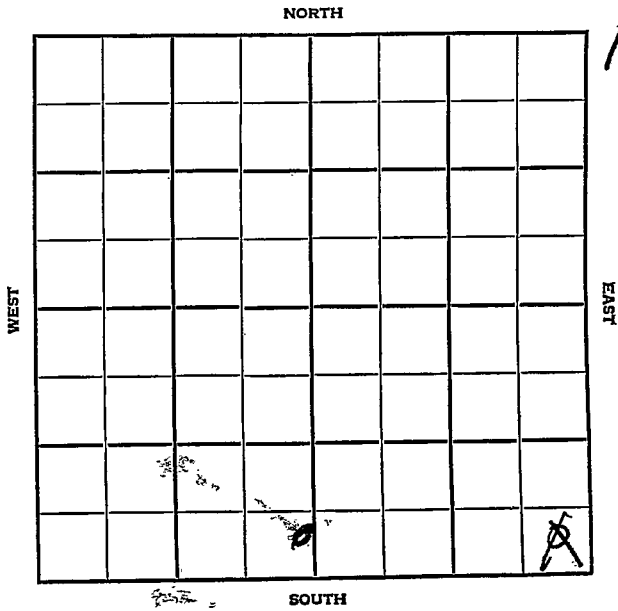

14

EllisKANSAS

SEC. 34 TWP. 11 R. 20W


WELL NO. 1 Homburg FARM

COMPANY Transit Corp.

CONTRACTOR

Wildcat

_____ Ft. from N. Line
 330 _____ Ft. from S. Line
 330 _____ Ft. from E. Line
 _____ Ft. from W. Line

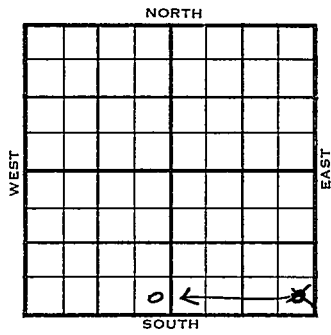

~~SE SE SW~~
~~SE S^E SE~~ Atl. & Lion-DHM Carter-AC

	ELEVATION	REPORT
1954	2157	

7/7
 7/21
 M I R,
 Spdg 7-5-54
 D&A
 TD 3965
 8" @ 186
 Anhy 1558 Heeb 3452 Tor 3474 Lans. 3490
 BKC 3714 Mar. 3785 Cong. 3824 Arb. 3935
 DST 3790-3805 open 20 min. Rec. 6' mud
 TD 3965
 D&A

ABANDONED

KANSAS

Map No. _____ Sec. 34 Twp. 11 R. 20W

Well No. 1 Homburg

Transit Corp. _____ Company

CORRECTION _____ Contractor

SE SE SW

SECTION PLAT

_____ Ft. from N. Line

330 Ft. from S. Line

330 Ft. from E. Line

_____ Ft. from W. Line

Ellis County

Location _____

Rig up _____

Drilling and Remarks:

Reported
SE SE SE

RECORD

Cased _____ in., _____ ft.

Sand _____

Gas _____

Oil _____

Total Depth _____

PRODUCTION

1st 24 hrs. Nat. _____

1st 24 hrs. after shot _____

Gas _____ Cu. Ft.

Dry Hole _____

Abandoned _____

Date

JUL 14 1954 19

J. G. McGEHEE

Scout

